


STATE OF KANSAS
STATE CORPORATION COMMISSION

WELL PLUGGING RECORD

Give All Information Completely
Make Required Affidavit
Mail or Deliver Report to:
Conservation Division
State Corporation Commission
800 Bitting Building
Wichita, Kansas

NORTH

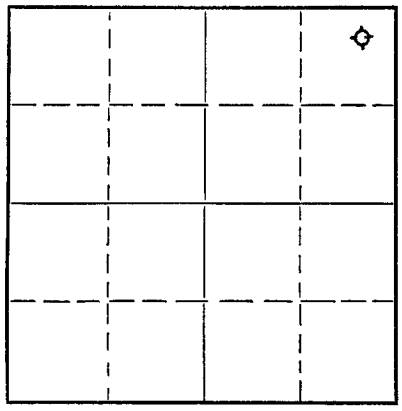

Locate well correctly on above
Section Plat

Rooks County. Sec. 19 Twp. 10S Rge. 19 (E) W (W)
Location as "NE/CNW $\frac{1}{4}$ SW $\frac{1}{4}$ " or footage from lines NE NE NE
Lease Owner C-G DRILLING CO. & N. APPELMAN CO.
Lease Name Berland Well No. I
Office Address 206 Union Natl Bank Bldg.
Character of Well (completed as Oil, Gas or Dry Hole) Dry Hole
Date well completed 6-1-52 19
Application for plugging filed 5-22-52 19
Application for plugging approved 5-22-52 19
Plugging commenced 5-27-52 19
Plugging completed 6-1-52 19
Reason for abandonment of well or producing formation Tested and was a dry hole

If a producing well is abandoned, date of last production --- 19
Was permission obtained from the Conservation Division or its agents before plugging was commenced? Yes

Name of Conservation Agent who supervised plugging of this well Eldon Petty, Hays, Kansas
Producing formation -- Depth to top -- Bottom -- Total Depth of Well -- Feet
Show depth and thickness of all water, oil and gas formations.

OIL, GAS OR WATER RECORDS

CASING RECORD

Formation	Content	From	To	Size	Put In	Pulled Out
				8-5/8"	190.98'	none
				5-1/2"	3781.30'	2886.87'

Describe in detail the manner in which the well was plugged, indicating where the mud fluid was placed and the method or methods used in introducing it into the hole. If cement or other plugs were used, state the character of same and depth placed, from --- feet to --- feet for each plug set.

Plugged hole with 19 ft. of rock in bottom and 5 sacks cement. Filled hole with mud to 190 ft. Set rock bridge at 190 ft. and 15 sacks cement. Filled hole with mud to 35 ft. Set rock bridge at 35 ft. Filled to top with 10 sacks cement.

RECEIVED
STATE CORPORATION COMMISSION
6-6-52
JUN 6 - 1952
CONSERVATION DIVISION
Wichita, Kansas
(If additional description is necessary, use BACK of this sheet)

Name of Plugging Contractor Bentley Cable Tools
Address Hoisington, Kansas


STATE OF KANSAS, COUNTY OF SEDGWICK, ss.
Operator, G. F. Galloway (Employer or owner or operator) of the above-described well, being first duly sworn on oath, says: That I have knowledge of the facts, statements, and matters herein contained and the log of the above-described well as filed and that the same are true and correct. So help me God.

(Signature) G. F. Galloway
206 Union National Bank Bldg.
Wichita 2, Kansas (Address)

SUBSCRIBED AND SWORN to before me this 3rd day of June, 19 52

My commission expires June 25, 1955

Wichita, Kansas
Notary Public.

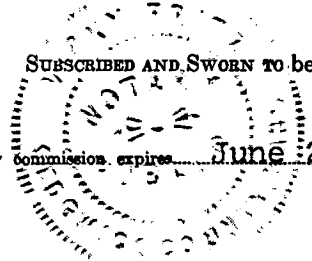

PLUGGING
FILE SEC 19 T 10 R 19
PAGE 21 LINE 9

CONTRACTOR'S WELL LOG

OPERATOR C-G DRILLING CO. FARM NAME BERLAND #1
 POOL NAME Semi-Wildcat COUNTY Rooks STATE Kansas
 LOCATION NE/4 NE/4 NE/4 Sec. 19, T. 10S., R. 19W.
 COMMENCEMENT DATE May 3, 1952 COMPLETION DATE May 14, 1952

LOG OF WELL

Elevation 2217 Kelly Bushing
 All measurements from the top of kelly bushing.

FROM	TO	FORMATION	DEVIATION FROM VERTICAL	REMARKS:
0	190			
190	450	Shale		
450	790	Shale-Shells		
790	840	Sand		
840	1090	Shale-Shells-Sand		
1090	1305	Sand		
1305	1410	Shale		
1410	1625	Shale	0° - 1500'	
1625	1665	Anhydrite		
1665	1835	Shale		
1835	2100	Shale	0° - 2000'	
2100	2230	Lime-Shale		
2230	2305	Lime-Shale		
2305	2420	Lime-Shale		
2420	2510	Lime-Shale	0° - 2500'	
2510	2600	Lime-Shale		
2600	2680	Lime-Shale		
2680	2735	Lime-Shale		
2735	2855	Lime-Shale		
2855	2950	Lime-Shale		
2950	3050	Lime-Shale	0° - 3000'	
3050	3150	Lime-Shale		
3150	3220	Lime-Shale		
3220	3310	Lime-Shale		
3310	3370	Lime		
3370	3405	Lime		
3405	3470	Lime		
3470	3510	Lime	0° - 3500'	
3510	3550	Lime		
3550	3600	Lime		
3600	3635	Lime		
3635	3675	Lime		
3675	3750	Lime-Shale		
3750	3780	Lime		

RECEIVED
 STATE CORPORATION COMMISSION
 JUN 6 - 1952

CONSERVATION DIVISION
 CASING LEFT IN HOLE AFTER COMPLETION
 Wichita, Kansas

Ran 190.98' (6 jts.) 8-5/8" OD Casing.
 Ran 3781.30' (118 jts.) 5-1/2" 14# Casing.

STATE OF KANSAS, COUNTY OF SEDGWICK) ss.

The undersigned certifies that to the best of his knowledge and belief, the above facts are true and correct.

C-G DRILLING CO.

By G. F. Galloway
 G. F. Galloway

Subscribed and sworn to before me this 16th day of May, 1952.

My commission expires:
 June 25, 1955

Vicky Lutz
 Notary Public

PLUGGING
 T. 10 S. R. 19 W.
 LINE 9