

CARD MUST BE TYPED

State of Kansas
NOTICE OF INTENTION TO DRILL

CARD MUST BE SIGNED

(see rules on reverse side)

Starting Date: 5 20 85
month day year 1:36

OPERATOR: License # 6033
Murrin Drilling Co.
Name
Address ..250 N. Water #300.....
City/State/Zip ..Wichita, KS.. 67202.....
Contact Person ..David Doyel.....
Phone 316 267-3274.....

CONTRACTOR: License # 6033
Name ..MDC.....
City/StateWichita, KS.....

Well Drilled For: Well Class: Type Equipment:
 Oil Swd Infield Mud Rotary
 Gas Inj Pool Ext. Air Rotary
 OWWO Expl Wildcat Cable

If OWWO: old well info as follows:
Operator
Well Name
Comp Date Old Total Depth
Projected Total Depth 3850 feet
Projected Formation at TD ... Arbuckle
Expected Producing Formations .. Arbuckle

API Number 15- 163-22,689-0000
W/2 W/2 SE Sec 17 Twp 10 S, Rge 19. East
(location) West

..... 1450 Ft North from Southeast Corner of Section
..... 2310 Ft West from Southeast Corner of Section
(Note: Locate well on Section Plat on reverse side)

Nearest lease or unit boundary line 1450 feet.
County Rooks
Lease Name Dennis Keller Well# 4-17
Domestic well within 330 feet : yes no
Municipal well within one mile : yes no

Depth to Bottom of fresh water 80 feet
Lowest usable water formation .. Dakota
Depth to Bottom of usable water 900 feet
Surface pipe by Alternate : 1 2
Surface pipe to be set 200 feet
Conductor pipe if any required
Ground surface elevation 2171 feet MSL
This Authorization Expires 11-20-85
Approved By 5-20-85 K.

I certify that we will comply with K.S.A. 55-101, et seq., plus eventually plugging hole to K.C.C. specifications.


Date 5/20/85 Signature of Operator or Agent *David Doyel*

Geologist Title
McElhone 5-20-85

Must be filed with the K.C.C. five (5) days prior to commencing well
This card void if drilling not started within six (6) months of date received by K.C.C.

Important procedures to follow :

A Regular Section of Land
1 Mile = 5,280 Ft.

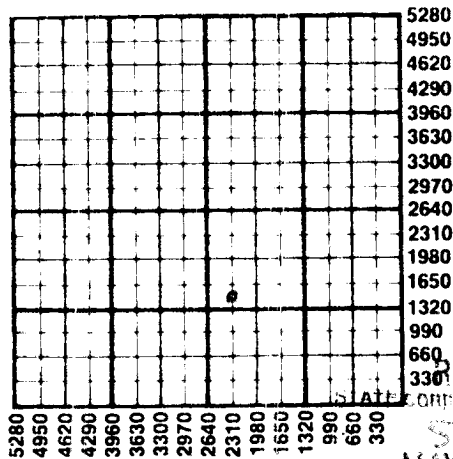

1. Notify District office before setting surface casing.
2. Set surface casing by circulating cement to the top.
3. File completion forms ACO-1 with K.C.C. within 90 days of well completion, following instructions on ACO-1, side 1, and including copies of wireline logs.
4. Notify District office 48 hours prior to old well workover or re-entry.
5. Prior to plugging, prepare a plugging plan, then obtain agreement from the appropriate district office for an approved plugging plan.
6. Submit plugging report (CP-4) to K.C.C. after plugging is completed.
7. Obtain an approved injection docket number before disposing of salt water.
8. Notify K.C.C. within 10 days when injection commences or terminates.
9. If an alternate 2 completion, cement in the production pipe from below any usable water to surface within 120 days of spud date.

RECEIVED
MAY 20 1985
CONSERVATION COMMISSION

CONSERVATION DIVISION
Wichita, Kansas

State Corporation Commission of Kansas
Conservation Division
200 Colorado Derby Building
Wichita, Kansas 67202
(316) 263-3238