


15-051-19237-00-00
WELL PLUGGING RECORD

Give All Information Completely
Make Required Affidavit
Mail or Deliver Report to:
Conservation Division
State Corporation Commission
211 No. Broadway
Wichita, Kansas

Ellis County, Sec. 9 Twp. 12S Rge. (E) 16 (W)

Location as "NE/CNW%SW%" or footage from lines NW NW NE
Lease Owner Whitestone Petroleum Corporation
Lease Name D. R. CHRISLER Well No. 1
Office Address 900 Vaughn Bldg., Dallas, Tex. 75201
Character of Well (completed as Oil, Gas or Dry Hole) Dry Hole
Date well completed - - 19 - -
Application for plugging filed October 21 19 63
Application for plugging approved October 21 19 63
Plugging commenced October 22 19 63
Plugging completed October 22 19 63
Reason for abandonment of well or producing formation No commercial zones

NORTH

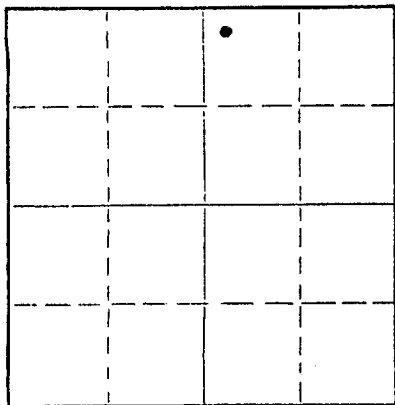

Locate well correctly on above Section Plat

If a producing well is abandoned, date of last production - - 19 - -
Was permission obtained from the Conservation Division or its agents before plugging was commenced? Yes

Name of Conservation Agent who supervised plugging of this well Eldon Petty, Hays, Kansas
Producing formation - - Depth to top - - Bottom - - Total Depth of Well 3450 Feet
Show depth and thickness of all water, oil and gas formations.

OIL, GAS OR WATER RECORDS

CASING RECORD

FORMATION	CONTENT	FROM	TO	SIZE	PUT IN	PULLED OUT

Describe in detail the manner in which the well was plugged, indicating where the mud fluid was placed and the method or methods used in introducing it into the hole. If cement or other plugs were used, state the character of same and depth placed, from _____ feet to _____ feet for each plug set.

20-Sack Plug 400'
20-Sack Plug 180'
10-Sack Plug 35'

Rest of hole was filled with 10.1#/gallon drilling mud.

RECEIVED
STATE CORPORATION COMMISSION

NOV 1 1963
11-1-1963

CONSERVATION DIVISION
Wichita, Kansas

(If additional description is necessary, use BACK of this sheet)

Name of Plugging Contractor Halliburton Company
Address Hays, Kansas

STATE OF TEXAS, COUNTY OF DALLAS, ss.
Dale O. Chase (employee of owner) or (~~owner or operator~~) of the above-described well, being first duly sworn on oath, says: That I have knowledge of the facts, statements, and matters herein contained and the log of the above-described well as filed and that the same are true and correct. So help me God.

(Signature) Dale O. Chase
900 Vaughn Bldg., Dallas, Texas 75201
(Address)

SUBSCRIBED AND SWORN to before me this 24th day of October, 19 63

My commission expires

6/1/65

Emmala Coody
Notary Public.

