


STATE OF KANSAS
STATE CORPORATION COMMISSION

WELL PLUGGING RECORD

Give All Information Completely
Make Required Affidavit
Mail or Deliver Report to
Conservation Division
State Corporation Comm.
245 North Water
Wichita, KS 67202

Rooks County, Sec. 20 Twp. 10S Rge. 19W E/W
Location as "NE/CNW $\frac{1}{4}$ SW $\frac{1}{4}$ " or footage from lines
C SE SW SE
Lease Owner Tomlinson Oil Company
Lease Name MAI Well No. 1
Office Address 200 W. Douglas, Suite 1030, Wichita, KS
Character of Well (Completed as Oil, Gas or Dry Hole)
Dry Hole

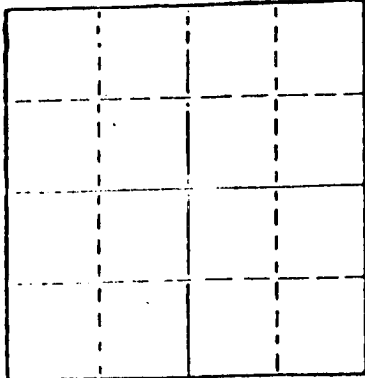

Locate well correctly on above
Section Plat

Date Well completed Sep. 19 1979
Application for plugging filed (verbally) Sep. 19 1979
Application for plugging approved (verbally) Sep. 19 1979
Plugging commenced Sep. 19 1979
Plugging completed Sep. 19 1979
Reason for abandonment of well or producing formation
No commercial quantity of oil or gas encountered
If a producing well is abandoned, date of last production
19

Was permission obtained from the Conservation Division or
its agents before plugging was commenced? Yes

Name of Conservation Agent who supervised plugging of this well Marion Schmidt
Producing formation _____ Depth to top _____ Bottom _____ Total Depth of Well 3845'
Show depth and thickness of all water, oil and gas formations.

OIL, GAS OR WATER RECORDS

CASING RECORD

FORMATION	CONTENT	FROM	TO	SIZE	PUT IN	PULLED OUT

Describe in detail the manner in which the well was plugged, indicating where the mud fluid
was placed and the method or methods used in introducing it into the hold. If cement or other
plugs were used, state the character of same and depth placed, from _____ feet to
_____ feet for each plug set.

T.D. 3845'
Set 1st plug at 820' with 70 sacks
2nd plug at 220' with 20 sacks
3rd plug at 40' solid bridge with 10 sacks
rathole with 3 sacks.
Cemented with 50/50 posmix, 6% gel.
Job was complete at 3:45 a.m., 09-19-79.

RECEIVED
STATE CORPORATION COMMISSION
9-26-79
SEP 26 1979
CONSERVATION DIVISION
Wichita, Kansas

(If additional description is necessary, use BACK of this sheet)

Name of Plugging Contractor Abercrombie Drilling, Inc.

STATE OF Kansas COUNTY OF Sedgwick, ss.
Jack L. Partridge, Asst. Sec.-Treas. (employee of owner) or (owner or operator)
of the above-described well, being first duly sworn on oath, says: That I have knowledge of
the facts, statements, and matters herein contained and the log of the above-described well
as filed and that the same are true and correct. So help me God.

(Signature) Jack L. Partridge
801 Union Center, Wichita, Kansas 67202
(Address)

SUBSCRIBED AND SWORN TO before me this 24th day of September, 19 79



Sherrie L. Brooks
Sherrie L. Brooks Notary Public.

My commission expires 08-21-82

CONTRACTOR'S WELL LOG

OPERATOR: Tomlinson Oil Company
 CONTRACTOR: Abercrombie Drilling, Inc.
 WELL NAME: Mai #1
 LOCATION: C SE SW SE, Section 20-10S-19W
 Rooks County, Kansas
 SPUD DATE: September 12, 1979
 COMPLETION DATE: September 19, 1979

0	1100	Sand and shale
1100	1342	Sand
1342	1622	Sand and shale
1622	1657	Anhydrite
1657	1790	Sand and shale
1790	2090	Shale
2090	2768	Shale and lime
2768	3445	Lime and shale
3445	3845	Lime
	3845	Rotary Total Depth

Spud hole at 7:15 p.m., September 12, 1979. Drilled 225' of 12 1/4" hole. Ran 5 joints of 8-5/8" - 24# new casing. Set at 222' K.B. Pumped plug to 207' K.B. Cemented with 150 sacks of common cement, 3% Ca.Cl., 2% gel. Cement did circulate. Plug was down at 12:00 midnight.

T.D. 3845'. Set 1st plug at 820' with 70 sacks, 2nd plug at 220' with 20 sacks, 3rd plug at 40' solid bridge with 10 sacks, rathole with 3 sacks. Cemented with 50/50 posmix, 6% gel. Job was complete at 3:45 a.m., September 19, 1979.

SAMPLE TOPS:

Anhydrite 1622'
 B/Anhydrite 1657'

RECEIVED
 STATE GEOLOGICAL COMMISSION
 SEP 20 1979

STATE OF KANSAS)
) ss
 COUNTY OF SEDGWICK)

CONSERVATION DIVISION
 Wichita, Kansas

Jack L. Partridge, Assistant Secretary-Treasurer of Abercrombie Drilling, Inc., does hereby state that the above and foregoing is a true and correct copy of the log of the Mai #1, C SE SW SE, Section 20-10S-19W, Rooks County Kansas.

ABERCROMBIE DRILLING, INC.

BY Jack L. Partridge
 Jack L. Partridge
 Assistant Secretary-Treasurer

Subscribed and sworn to before me, a Notary Public, in and for the county and state aforesaid, as of this 24th day of September, 1979.


 SHERRIE L. BROOKS
 Sedgwick County, Ks.
 My Appt. Exp. 08-21-82

Sherrie L. Brooks
 Sherrie Brooks, Notary Public

My commission expires 08-21-82.