

15-163 - 03718-0000

STATE OF KANSAS  
STATE CORPORATION COMMISSION

WELL PLUGGING RECORD

Give All Information Completely  
Make Required Affidavit  
Mail or Deliver Report to:  
Conservation Division  
State Corporation Commission  
800 Bitting Building  
Wichita, Kansas

Rooks \_\_\_\_\_ County. Sec. 20 Twp. 10 Rge. (E) 19 (W)

Location as "NE/CNW%SW%" or footage from lines SW SW SE

Lease Owner Colorado Oil and Gas Corporation

Lease Name Tomasheck Well No. 1

Office Address Box 1030 Wichita, Kansas

Character of Well (completed as Oil, Gas or Dry Hole) Oil

Date well completed April 24 1954

Application for plugging filed December 19 1955

Application for plugging approved December 20 1955


Plugging commenced January 4 1956

Plugging completed January 9 1956

Reason for abandonment of well or producing formation Producing formation depleted.

If a producing well is abandoned, date of last production December 15 1955

Was permission obtained from the Conservation Division or its agents before plugging was commenced? Yes

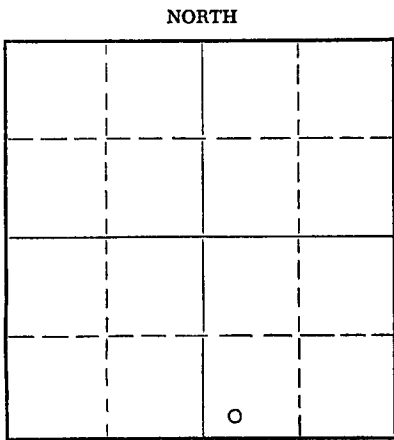

Locate well correctly on above Section Plat

Name of Conservation Agent who supervised plugging of this well Eldon Petty

Producing formation Arbuckle Depth to top 3779 Bottom \_\_\_\_\_ Total Depth of Well 3787 Feet

Show depth and thickness of all water, oil and gas formations.

OIL, GAS OR WATER RECORDS

CASING RECORD

FORMATION	CONTENT	FROM	TO	SIZE	PUT IN	PULLED OUT
Arbuckle		3779		8 5/8 5 1/2	212' 3781'	None 3005'

Describe in detail the manner in which the well was plugged, indicating where the mud fluid was placed and the method or methods used in introducing it into the hole. If cement or other plugs were used, state the character of same and depth placed, from \_\_\_\_\_ feet to \_\_\_\_\_ feet for each plug set.

Filled back to 3770'. Dumped 4 sacks of cement at 3770'. Shot pipe off at 3022'. Pulled pipe and mudded hole to 210'. Set rock bridge and dumped 15 sacks of cement at 210'. Finished mudding hole to 40' and dumped 10 sacks of cement in top of surface.

(If additional description is necessary, use BACK of this sheet)

Name of Plugging Contractor Bert Self Casing Pulling Company

Address R.R. #4 Hutchinson, Kansas

STATE OF Kansas, COUNTY OF Reno, ss.

Bill K. Henrichs (employee of owner) or (owner or operator) of the above-described well, being first duly sworn on oath, says: That I have knowledge of the facts, statements, and matters herein contained and the log of the above-described well as filed and that the same are true and correct. So help me God.


(Signature) Bill K. Henrichs  
Bill K. Henrichs  
Box 1030, Wichita, Kansas  
(Address)

SUBSCRIBED AND SWORN to before me this 24th day of January, 19 56

H. A. Bilson  
Notary Public.

My commission expires August 24, 1957

24-7968-S 3-53-20M

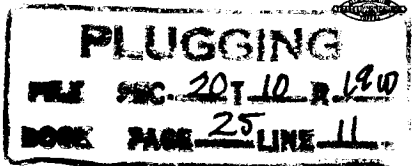

1-25-56

DRILLERS' LOG

Company: The Derby Oil Company  
 Farm Name: Tomasheck Well No. 1  
 Total Depth: 3787'  
 Comm: 4-6-54 Comp: 4-15-54  
 Contractor: Glenn W. Peel  
 Casing: 8 5/8" 212' cem.  
 5 1/2" 3781' cem.

C SW SW SE  
 Sec. 20, Twp. 10S, Rge. 19W,  
 County: Rooks,  
 Kansas  
 Elevation:  
 Production:

Figures below indicate bottoms of formations:

Surface soils and sands	0 -	212
Shale		800
Sand		950
Shale and sand		1300
Shale		1620
Anhydrite		1660
Shale and shales		2140
Lime and shale		2640
Lime		2850
Shale and lime		3425
Lime		3787
Total Depth		3787

This is to certify that the above information is to the best of our knowledge, true and correct.

GLENN W. PEEL

BY: *Glenn W. Peel*

SUBSCRIBED AND SWORN to before me this 16<sup>th</sup> day of April, 1954.

My commission expires: June 4, 1955

*Marion M. Herbert*  
 Notary Public

**PLUGGING**

FILE SEC 20 T 10 R 19W  
 BOOK PAGE 25 LINE 11