


STATE OF KANSAS  
STATE CORPORATION COMMISSION

Form CP-4

Give All Information Completely  
Make Required Affidavit  
Mail or Deliver Report to:  
Conservation Division  
State Corporation Commission  
P. O. Box 17027  
Wichita, Kansas 67217  
NORTH

WELL PLUGGING RECORD

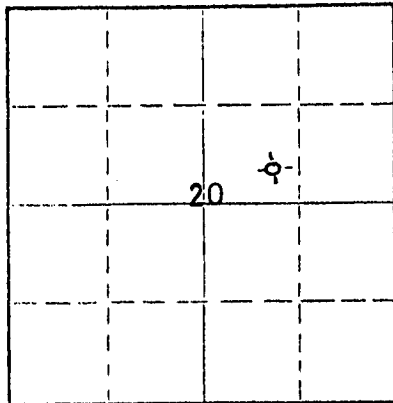

Locate well correctly on above  
Section Plat

ROOKS County, Sec. 20 Twp. 10S Rge. 19 (E) (W)  
Location as "NE/CNWxSWx" or footage from lines SE SW NE  
Lease Owner ZORGER OIL CO.  
Lease Name BERLAND Well No. 1  
Office Address 706 UNION NATIONAL BLDG., WICHITA, KS 67202  
Character of Well (completed as Oil, Gas or Dry Hole) DRY HOLE  
Date well completed AUGUST 30 19 75  
Application for plugging filed AUGUST 30 19 75  
Application for plugging approved AUGUST 30 19 75  
Plugging commenced AUGUST 30 19 75  
Plugging completed AUGUST 30 19 75  
Reason for abandonment of well or producing formation  
TOO LOW STRUCTURALLY  
If a producing well is abandoned, date of last production 19  
Was permission obtained from the Conservation Division or its agents before plugging was commenced? YES

Name of Conservation Agent who supervised plugging of this well LEO F MASSEY  
Producing formation \_\_\_\_\_ Depth to top \_\_\_\_\_ Bottom \_\_\_\_\_ Total Depth of Well 3764 Feet  
Show depth and thickness of all water, oil and gas formations.

OIL, GAS OR WATER RECORDS

CASING RECORD

FORMATION	CONTENT	FROM	TO	SIZE	PUT IN	PULLED OUT
				8 5/8"	242.85'	NONE

Describe in detail the manner in which the well was plugged, indicating where the mud fluid was placed and the method or methods used in introducing it into the hole. If cement or other plugs were used, state the character of same and depth placed, from \_\_\_\_\_ feet to \_\_\_\_\_ feet for each plug set.

FILLED WITH HEAVY MUD TO 660' SET  
PLUG. PUT IN 70 SACKS CEMENT. FILLED  
WITH HEAVY MUD TO 240'. SET PLUG.  
PUT IN 20 SACKS CEMENT. FILLED WITH  
HEAVY MUD TO 40'. SET PLUG. FILLED  
TO TOP WITH 10 SACKS CEMENT & 1 SACK  
HULLS.

9-23-75


(If additional description is necessary, use BACK of this sheet)

Name of Plugging Contractor C-G DRILLING CO.  
Address 1107 UNION NATIONAL BUILDING, WICHITA, KANSAS 67202

STATE OF KANSAS, COUNTY OF SEDGWICK, ss.  
G. F. Galloway (employee of owner) or (owner or operator) of the above-described well, being first duly sworn on oath, says: That I have knowledge of the facts, statements, and matters herein contained and the log of the above-described well as filed and that the same are true and correct. So help me God.

(Signature) G. F. Galloway  
1107 Union National Bldg., Wichita, Ks.  
(Address)

Subscribed and sworn to before me this 5th day of September, 1975

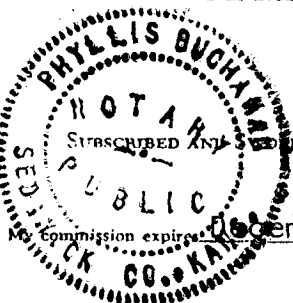

Phyllis Buchanan  
Notary Public.

W E L L L O G

OPERATOR: ZORGER OIL CO.  
 WELL NAME: BERLAND #1 LOCATION: SE SW NE SEC 20-T10S-R19W  
 COUNTY: ROOKS STATE: KANSAS  
 WELL COMMENCED: 8/19/75 WELL COMPLETED: 8/30/75  
 ELEVATION: 2187 KB TOTAL DEPTH: 3764'  
 PRODUCTION: DRY & ABANDONED RIG NO: 1  
 CASING - 8-5/8": 6 JTS (242.85) USED 28# W/160 SX COMMON #2% GEL 3% CA CL  
 5-1/2": \_\_\_\_\_

ALL MEASUREMENTS TAKEN FROM THE TOP OF ROTARY BUSHING:

FROM	TO	FORMATION	DEVIATION FROM VERTICAL	REMARKS:
0	70	SAND		
70	242	SHALE		
242	710	SHALE & SAND		
710	920	SAND		
920	1060	SHALE		
1060	1295	SAND		
1295	1586	RED BED & SHALE		
1586	1621	ANHYDRITE	1/2 @ 1607'	
1621	2045	SHALE		
2045	2311	SHALE & SHELLS		DST #1 37174'-3245' MISRUM
2311	2681	SHALE		DST #2 3188'-3245' 38'-30-30-30
2681	3345	LIME & SHALE		REC 700' MUDDY SALT WTR
3345	3764	LIME		IBHP 1027#, FBHP 1013#, IFP 73# FFP392#
	3765	RTD		DST #3 3451'-3510' 30-30-30-30 1/2

DST #7 3743'-7350' 30-30-30-30  
 WEAK BLOW F/25 MIN.REC 30'MUD W/  
 FEW SPECKS OIL  
 IBHP 1027# IFP 29# FFP 36# FBHP 918#  
 DST #8 3748'-3755' 30- 30  
 M W/SPOTS OIL  
 IBHP 1042# FSI# NOT TAKEN IFP NOT  
 TAKEN FFP 29#  
 DST #9 3755'-3764' 45-45-60-60  
 REC 2025' OIL WTR 10% OIL  
 IBHP 1136# IFP 59# FFP 940# IFP 1136#  
 STATE OF KANSAS )  
 COUNTY OF SEDGWICK) SS:

The undersigned hereby certifies that to the best of his knowledge and belief, the above facts are true and correct.

C-G DRILLING CO.

By G F Galloway

G F GALLOWAY

SUBSCRIBED AND SWORN TO, BEFORE ME, This 5th day of Sept., 1975.

MY COMM. EXP. DEC. 7, 1975

Phyllis Buchanan  
 PHYLLIS BUCHANAN - NOTARY PUBLIC

