

15-163-00631-0000


STATE OF KANSAS
STATE CORPORATION COMMISSION

WELL PLUGGING RECORD

Give All Information Completely
Make Required Affidavit
Mail or Deliver Report to:
Conservation Division
State Corporation Commission
800 Biting Building
Wichita, Kansas

Rooks County. Sec. 20 Twp. 10 Rge. (E) 19 (W)

NORTH

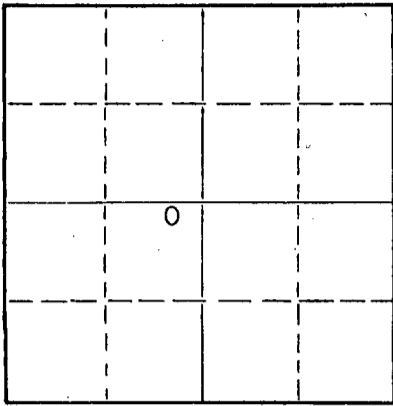

Locate well correctly on above
Section Plat

Location as "NE/CNW/SW" or footage from lines NE NE SW
Lease Owner Colorado Oil and Gas Corporation
Lease Name Berland Well No. 1
Office Address Box 1030 Wichita, Kansas
Character of Well (completed as Oil, Gas or Dry Hole) oil
Date well completed December 9 1953
Application for plugging filed April 21 1955
Application for plugging approved April 22 1955
Plugging commenced May 6 1955
Plugging completed May 10 1955
Reason for abandonment of well or producing formation Producing zone depleted

If a producing well is abandoned, date of last production February 1955
Was permission obtained from the Conservation Division or its agents before plugging was commenced? Yes

Name of Conservation Agent who supervised plugging of this well Eldon Petty
Producing formation Arbuckle Depth to top 3773 Bottom _____ Total Depth of Well 3782 Feet
Show depth and thickness of all water, oil and gas formations.

OIL, GAS OR WATER RECORDS

CASING RECORD

FORMATION	CONTENT	FROM	TO	SIZE	PUT IN	PULLED OUT
Arbuckle	oil	3773	3782	8 5/8 5 1/2	214 3778	None 3200'

Describe in detail the manner in which the well was plugged, indicating where the mud fluid was placed and the method or methods used in introducing it into the hole. If cement or other plugs were used, state the character of same and depth placed, from _____ feet to _____ feet for each plug set.

Filled back with chat to 3370'. Dumped 4 sacks of cement. Shot pipe off at 3220'. Pulled pipe and mudded hole to 235'. Set rock bridge and dumped 15 sacks of cement. Finished mudding hole to 35' and dumped 10 sacks of cement.

(If additional description is necessary, use BACK of this sheet)

Name of Plugging Contractor Bert Self
Address Hutchinson, Kansas

STATE OF KANSAS, COUNTY OF SEDGWICK, ss.
BILL K. HENRICHS (employee of owner) or (~~owner~~) of the above-described well, being first duly sworn on oath, says: That I have knowledge of the facts, statements, and matters herein contained and the log of the above-described well as filed and that the same are true and correct. So help me God.

(Signature) Bill K. Henrichs
Box 1030 Wichita, Kansas
(Address)

SUBSCRIBED AND SWORN to before me this 26th day of May, 1955

Notary Public.

My commission expires August 24, 1957

PLUGGING
FILE SEC 20 T 10 R 19W
BOOK PAGE 114 LINE 8

RECEIVED
STATE CORPORATION COMMISSION
5-27-55
CONSERVATION DIVISION
WICHITA, KANSAS

DRILLER'S LOG

Company: The Derby Oil Company
 Farm Name: Berland Well No. 1
 Total Depth: 3782'
 Comm: 7-16-53 Comp: 7-29-53
 Contractor: Glenn W. Peel
 Casings: 8 5/8" 214' cem.
 5 1/2" 3778' cem.

C M NE SW
 Sec. 20, Twp. 10S, Rge 19W,
 County: Rooks,
 Kansas
 Elevation:
 Production:

Figures below indicate bottom of formations:

Top soil and sand	0 -	150
Shale		760
Sand and shale		1125
Shale and Red bed		1585
Shale and shells		1600
Anhydrite		1860
Shale and shells		2350
Lime		2605
Shale and Lime		2785
Lime		2825
Lime and shale		3170
Lime		3405
Lime and shale		3445
Lime		3680
Conglom rate chert		3720
Chert and Lime		3771
Conglomerate and Arbuckle		3777
Arbuckle		3782
Total Depth		3782

This is to certify that the above information is to the best of our knowledge, true and correct.

GLENN W. PEEL

BY: Way Herbert

SUBSCRIBED AND SWORN to before me this 4th day of August, 1953.

My Commission expires June 4, 1955

Marion M. Herbert
 Notary Public

20-10-19W
 114-8