


Give All Information Completely
Make Required Affidavit
Mail or Deliver Report to:
Conservation Division
State Corporation Commission
212 No. Market
Wichita, Kansas

WELL PLUGGING RECORD

NORTH

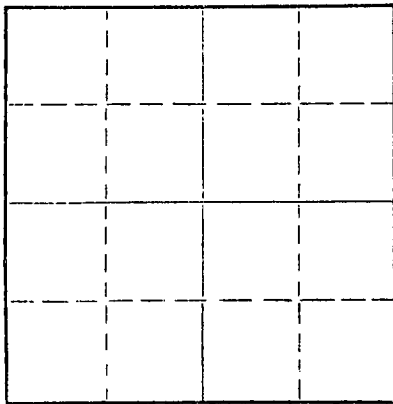

Locate well correctly on above
Section Plat

Rooks County. Sec. 20 Twp. 10 Rge. (E) 19 (W)
Location as "NE/CNW/SW" or footage from lines NW SW NE
Lease Owner Rex & Morris Drilling Co.
Lease Name Berland Well No. 2
Office Address P. O. Box 334, El Dorado, Kansas 67042
Character of Well (completed as Oil, Gas or Dry Hole) Dry Hole
Date well completed Jan. 29, 1969
Application for plugging filed Feb. 5, 1969
Application for plugging approved Jan. 29, 1969
Plugging commenced Jan. 29, 1969
Plugging completed Jan. 29, 1969
Reason for abandonment of well or producing formation _____

If a producing well is abandoned, date of last production 19
Was permission obtained from the Conservation Division or its agents before plugging was commenced? Yes

Name of Conservation Agent who supervised plugging of this well Leo Massey
Producing formation _____ Depth to top _____ Bottom _____ Total Depth of Well 3790 Feet
Show depth and thickness of all water, oil and gas formations.

OIL, GAS OR WATER RECORDS

CASING RECORD

FORMATION	CONTENT	FROM	TO	SIZE	PUT IN	PULLED OUT
		0	207'	8-5/8"	207'	None

Describe in detail the manner in which the well was plugged, indicating where the mud fluid was placed and the method or methods used in introducing it into the hole. If cement or other plugs were used, state the character of same and depth placed, from _____ feet to _____ feet for each plug set.

Filled hole with heavy mud to 800 ft. Set first plug @ 800 ft. w/70 sacks cement.
Filled hole with heavy mud to 210 ft. Set second plug @ 210 ft. w/20 sacks cement.
Filled hole with heavy mud to 40 ft. Set third plug @ 40 ft. w/10 sacks cement.
Plugged rat hole with 2 sacks cement. Job complete @ 4 A.M., 1-29-68. Job by Sun.

RECEIVED
STATE CORPORATION COMMISSION
FEB 6 1969
CONSERVATION DIVISION
Wichita, Kansas

(If additional description is necessary, use BACK of this sheet)
Name of Plugging Contractor Gabbert-Jones, Inc.
Address 830 Sutton Place, Wichita, Kansas 67202


STATE OF Kansas, COUNTY OF Sedgwick, ss.
E. E. Hall (employee of owner) or (owner or operator) of the above-described well, being first duly sworn on oath, says: That I have knowledge of the facts, statements, and matters herein contained and the log of the above-described well as filed and that the same are true and correct. So help me God.

(Signature) E E Hall
830 Sutton Place, Wichita, Kansas 67202
(Address)

SUBSCRIBED AND SWORN TO before me this 5 day of February, 19 69

Barbara J. Layton
Barbara J. Layton Notary Public.

Feb. 1, 1972.

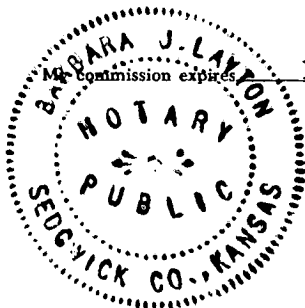

GABBERT-JONES, INC.
WICHITA, KANSAS
DRILLERS' WELL LOG

BERLAND #2
NW SW NE Section 20-10S-19W
Rooks County, Kansas

Commenced: January 20, 1969
Completed: January 29, 1969

OPERATOR - Rex & Morris Drilling Co.

DEPTH		FORMATION	REMARKS
From	To		
0	85	Sand	
85	207	Shale	Ran 6 joints of 8-5/8" casing, set @ 207' w/165 sacks cement.
207	585	Shale	
585	1095	Shale and sand	
1095	1350	Sand	
1350	1385	Shale	
1385	1615	Shale and red bed	
1615	1654	Anhydrite	
1654	2265	Shale	
2265	3437	Shale and lime	
3437	3560	Lime	
3560	3607	Lime and chert	
3607	3790	Lime	
3790	TD		Dry and abandoned.


I, E. E. HALL, certify this is a correct copy of the Drillers' Log for the well drilled in the NW SW NE Section 20-10S-19W, Rooks County, Kansas, to the best of my knowledge and belief.

E. E. Hall

E. E. HALL

STATE OF KANSAS)
) SS
COUNTY OF SEDGWICK)

Before me, the undersigned, a Notary Public within and for said County and State, on this 5 day of February, 1969, personally appeared E. E. Hall to me personally known to be the identical person who executed the within and foregoing instrument and acknowledged to me that he executed the same as his free and voluntary act and deed for the uses and purposes therein set forth.

IN WITNESS WHEREOF, I have hereunto set my hand and official seal the day and year last above written.

My Commission Expires Feb. 1, 1972.

Barbara J. Layton
Barbara J. Layton, Notary Public

