


Give All Information Completely
Make Required Affidavit
Mail or Deliver Report to:
Conservation Division
State Corporation Commission
211 No. Broadway
Wichita, Kansas

WELL PLUGGING RECORD

15-163-00956-000

NORTH

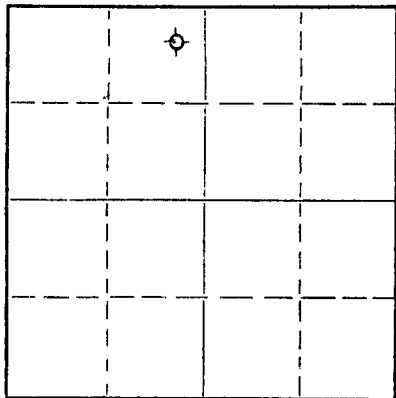

Locate well correctly on above
Section Plat

ROOKS

County. Sec. 20 Twp. 10 Rge. 19 (E) W (W)

Location as "NE/CNW&SW&" or footage from lines NE NE NW

Lease Owner C-G DRILLING CO. & OIL TRADING OIL CORP.

Lease Name BERLAND "A"

Well No. 1

Office Address 107 RULE BLDG., WICHITA, KANSAS

Character of Well (completed as Oil, Gas or Dry Hole) DRY HOLE

Date well completed April 2 1956

Application for plugging filed April 2 1956

Application for plugging approved April 2 1956

Plugging commenced April 3 1956

Plugging completed April 3 1956

Reason for abandonment of well or producing formation Too low structurally

If a producing well is abandoned, date of last production 19

Was permission obtained from the Conservation Division or its agents before plugging was commenced? Yes

Name of Conservation Agent who supervised plugging of this well Eldon Petty, Hays, Kansas

Producing formation Depth to top Bottom Total Depth of Well 3792 Feet

Show depth and thickness of all water, oil and gas formations.

OIL, GAS OR WATER RECORDS

CASING RECORD

| FORMATION | CONTENT | FROM | TO | SIZE | PUT IN | PULLED OUT |
|-----------|---------|------|----|--------|--------|------------|
| | | | | 8-5/8" | 184' | none |
| | | | | | | |
| | | | | | | |
| | | | | | | |
| | | | | | | |
| | | | | | | |
| | | | | | | |
| | | | | | | |
| | | | | | | |

Describe in detail the manner in which the well was plugged, indicating where the mud fluid was placed and the method or methods used in introducing it into the hole. If cement or other plugs were used, state the character of same and depth placed, from feet to feet for each plug set.

Filled hole with heavy mud to 179'.
Set plug. Put in 1/2 sack Halls and 15
sacks cement. Filled with heavy mud to
40'. Set plug. Filled to top with 1/2
sack Halls and 10 sacks cement.

(If additional description is necessary, use BACK of this sheet)

Name of Plugging Contractor C-G Drilling Co.

Address 107 Rule Bldg., Wichita, Kansas

STATE OF KANSAS, COUNTY OF SEDGWICK, ss.

Jay H. Galloway

(employee of owner) or (owner or operator) of the above-described

well, being first duly sworn on oath, says: That I have knowledge of the facts, statements, and matters herein contained and the log of the above-described well as filed and that the same are true and correct. So help me God.

(Signature) Jay H. Galloway

107 Rule Bldg.
(Address)

SUBSCRIBED AND SWORN TO before me this 4th day of April, 1956

Vicky Jacobs

Notary Public.

My commission expires May 20, 1959

PLUGGING

FILE SEC 20 T 10 R 19W

BOOK PAGE 51 LINE 30

4-6-56

CONTRACTOR'S WELL LOG

OPERATOR C-G DRILLING CO. & OIL TRADING OIL CORPORATION WELL NAME BERLAND "A" #1

LOCATION NE NE NW Sec 20-10-19W RIG NO. 2

COUNTY ROOKS STATE KANSAS

COMMENCEMENT DATE MARCH 22, 1956 COMPLETION DATE April 3, 1956

LOG OF WELL

Elevation 2192' rotary bushing.
All measurements taken from top of rotary bushing.

| | | | DEVIATION | REMARKS |
|------|------|---------------|---------------|-----------------|
| FROM | TO | FORMATION | FROM VERTICAL | |
| 0 | 180 | Surface Soil | | |
| 180 | 960 | Shale-Shells | | |
| 960 | 1050 | Shale | | |
| 1050 | 1400 | Sand-Shale | | |
| 1400 | 1450 | Shale | | |
| 1450 | 1540 | Shale-Red Bed | | |
| 1540 | 1617 | Shale-Red Bed | | |
| 1617 | 1673 | Anhydrite | | |
| 1673 | 1890 | Shale-Shells | | |
| 1890 | 2110 | Shale | | |
| 2110 | 2270 | Shale-Lime | | |
| 2270 | 2445 | Shale-Lime | | |
| 2445 | 2545 | Shale-Lime | 0° - 2500 | |
| 2545 | 2755 | Shale-Lime | 0° - 2750 | |
| 2755 | 2845 | Shale-Lime | - | |
| 2845 | 2915 | Shale-Lime | | |
| 2915 | 3030 | Shale-Lime | 0° - 3000 | |
| 3030 | 3145 | Shale-Lime | | |
| 3145 | 3261 | Shale-Lime | 0° - 3250 | |
| 3261 | 3328 | Shale-Lime | - | |
| 3328 | 3425 | Shale-Lime | | |
| 3425 | 3517 | Shale-Lime | 0° - 3500 | |
| 3517 | 3580 | Lime | | |
| 3580 | 3644 | Lime-Shale | | |
| 3644 | 3727 | Shale-Lime | | DST 3695 - 3727 |
| 3727 | 3792 | Shale-Lime | 0° - 3750 | |
| | 3792 | TD | | |

CASING LEFT IN HOLE AFTER COMPLETION
184' of 8-5/8" OD Surface Casing

STATE OF KANSAS, COUNTY OF SEDGWICK) SS.

The undersigned hereby certifies that to the best of his knowledge and belief, the above facts are true and correct.

C-G DRILLING CO.

By Jay H. Galloway

Subscribed and sworn to before me on this 4th day of April, 1956.

My commission expires:
May 20, 1959

Vicky Jacobs
Vicky Jacobs, Notary Public

PLUGGING
FILE SEC 30 10 R 19W
BOOK PAGE 51 LINE 30