


WELL PLUGGING RECORD

Give All Information Completely
Make Required Affidavit
Mail or Deliver Report to:
Conservation Division
State Corporation Commission
800 Biting Building
Wichita, Kansas

NORTH

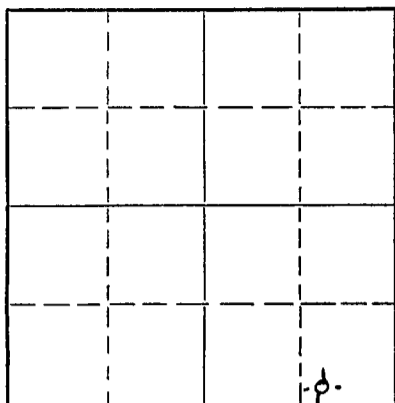

Locate well correctly on above
Section Plat

Rooks County. Sec. 21 Twp. 10S Rge. 19W (E) (W)
Location as "NE/CNW/SW" or footage from lines SW SE SE
Lease Owner Herman G. Kaiser & K & E Drilling, Inc.
Lease Name Dick Well No. 1
Office Address 908 Palace Bldg., Tulsa, Okla.; 1006 Central Bldg., Wichita
Character of Well (completed as Oil, Gas or Dry Hole) Dry hole
Date well completed March 21 19 54
Application for plugging filed March 21 19 54
Application for plugging approved March 21 19 54
Plugging commenced 4:00 p.m., March 21 19 54
Plugging completed 11:30 p.m., March 21 19 54
Reason for abandonment of well or producing formation
Commercial quantity of oil not found
If a producing well is abandoned, date of last production 19
Was permission obtained from the Conservation Division or its agents before plugging was commenced? Yes

Name of Conservation Agent who supervised plugging of this well M. A. Rives
Producing formation Depth to top Bottom Total Depth of Well 3732 Feet
Show depth and thickness of all water, oil and gas formations.

OIL, GAS OR WATER RECORDS

CASING RECORD

FORMATION	CONTENT	FROM	TO	SIZE	PUT IN	PULLED OUT
				8 5/8"	208	

Describe in detail the manner in which the well was plugged, indicating where the mud fluid was placed and the method or methods used in introducing it into the hole. If cement or other plugs were used, state the character of same and depth placed, from feet to feet for each plug set.

Set plug @ 200' w/15 sacks cement
Set plug @ 40' w/10 sacks cement

3-26-54

(If additional description is necessary, use BACK of this sheet)

Name of Plugging Contractor K & E Drilling, Inc.
Address 1006 Central Building, Wichita, Kansas


STATE OF Kansas, COUNTY OF Sedgwick, ss.
Clinton Engstrand (employee of owner) or (owner or operator) of the above-described well, being first duly sworn on oath, says: That I have knowledge of the facts, statements, and matters herein contained and the log of the above-described well as filed and that the same are true and correct. So help me God.

(Signature) *Clinton Engstrand*
1006 Central Building, Wichita, Kansas
(Address)

SUBSCRIBED AND SWORN TO before me this 25 day of March, 19 54

Walter Rogers
Notary Public.

My commission expires 10-29-55

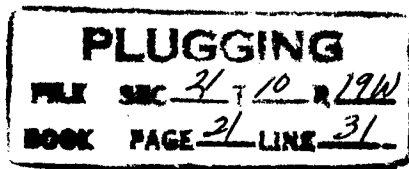

15-163-00698-0000

HERMAN GEORGE KAISER & K & E DRILLING, INC.
No. 1 Dick

SW SE SE Section 21-10S-19W
Rooks County, Kansas

Casing
8 5/8" Set @ 208'

Cement
135 Sacks

Comm: 3-8-54
Comp: 3-21-54
Total Depth: 3732'

<u>FORMATION</u>	<u>DEPTH</u>
Sand	0 - 190
Shale	190 - 208
Shale	208 - 415
Shale	415 - 596
Sand	596 - 635
Shale and sand	635 - 790
Sand	790 - 830
Shale	830 - 1154
Sand	1154 - 1272
Shale (Sand strks.)	1272 - 1390
Sand, shale and shells	1390 - 1528
Anhydrite	1528 - 1570
Shale and shells	1570 - 1635
Shale	1635 - 1865
Shale and shells	1865 - 2070
Shale and shells	2070 - 2100
Lime and shale	2100 - 2215
Lime and shale	2215 - 2290
Lime - shale	2290 - 2375
Lime and shale	2375 - 2500
Shale and lime	2500 - 3209
Lime	3209 - 3272
Lime and shale	3272 - 3332
Lime	3332 - 3365
Lime and shale	3365 - 3421
Lime	3421 - 3446
Lime	3446 - 3649
Conglomerate	3649 - 3671
Conglomerate chert	3671 - 3703
Shale and dolomite, chert	3703 - 3719
Shale - dolomite	3719 - 3723
Lime	3723 - 3732

STATE OF KANSAS)
) SS
SEDGWICK COUNTY)

I hereby certify that the above information is true and correct to the best of my knowledge.

[Handwritten Signature]

Subscribed and sworn to before me this 25 day of March, 1954.

[Handwritten Signature]
Notary Public

My Commission Expires: 10-29-55

PLUGGING
WELL SEC 21-10-19W
BOOK PAGE 2 LINE 31