

STATE OF KANSAS  
STATE CORPORATION COMMISSION

WELL PLUGGING RECORD


Give All Information Completely  
Make Required Affidavit  
Mail or Deliver Report to:  
Conservation Division  
State Corporation Commission  
800 Bitting Building  
Wichita, Kansas

OR  
FORMATION PLUGGING RECORD

Strike out upper line  
when reporting plugging  
off formations.

Rooks County. Sec. 26 Twp. 10 Rge. 19 (E/W) (W)  
Location as "NE 1/4 NW 1/4 SW 1/4" or footage from lines. NE SW SW  
Lease Owner. A. D. Allison  
Lease Name. Smith-Holderman Well No. 1  
Office Address. 716 Brown Bldg., Wichita, Kansas  
Character of Well (completed as Oil, Gas or Dry Hole). Dry Hole  
Date well completed. August 22, 19 47  
Application for plugging filed. October 8, 19 47  
Application for plugging approved. October 15, 19 47  
Plugging commenced. October 13, 19 47  
Plugging completed. October 13, 19 47  
Reason for abandonment of well or producing formation. Dry Hole

NORTH

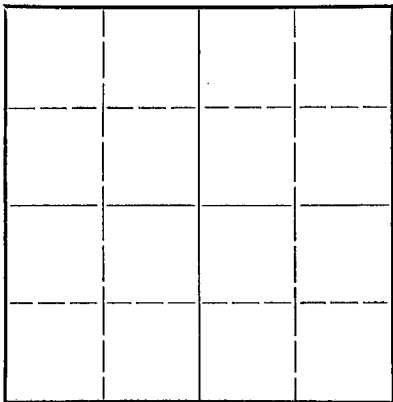

Locate well correctly on above  
Section Plat

If a producing well is abandoned, date of last production. 19...  
Was permission obtained from the Conservation Division or its agents before plugging was commenced? Yes

Name of Conservation Agent who supervised plugging of this well. C. D. Stough  
Producing formation. Depth to top. Bottom. Total Depth of Well. 3694 Feet  
Show depth and thickness of all water, oil and gas formations.


OIL, GAS OR WATER RECORDS

CASING RECORD

Formation	Content	From	To	Size	Put In	Pulled Out

Describe in detail the manner in which the well was plugged, indicating where the mud fluid was placed and the method or methods used in introducing it into the hold. If cement or other plugs were used, state the character of same and depth placed, from...feet to...feet for each plug set.

Surface pipe 8-5/8" 185 feet. Circulated with cement. 5 1/2" Casing set at 3562 feet and cemented with 125 sacks of cement. Filled hole back from bottom to 3340 feet. Set plug and 5 sacks cement at 3340 feet above all perforations in the 5 1/2" casing. Shot off and recovered 2600 feet of 5 1/2" casing. Filled hole with mud to 185 feet. Set plug and 15 sacks cement at 185 feet. Surface plug 20 feet below the surface and 10 sacks cement. Filled hole to surface. Mud between plugs.

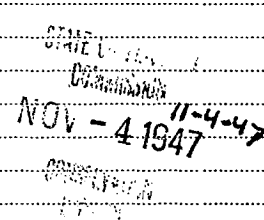

(If additional description is necessary, use BACK of this sheet)

Correspondence regarding this well should be addressed to. A. D. Allison  
Address. 716 Brown Bldg., Wichita, Kansas


STATE OF....., COUNTY OF....., ss.  
..... (employee of owner) or (owner or operator) of the above-described well,  
being first duly sworn on oath, says: That I have knowledge of the facts, statements, and matters herein contained and the log of the above-described well as filed and that the same are true and correct. So help me God.

(Signature) *A. D. Allison*  
(Address) 716 Brown Bldg., Wichita

SUBSCRIBED AND SWORN to before me this..... day of....., 19.....

My commission expires.....

Notary Public.

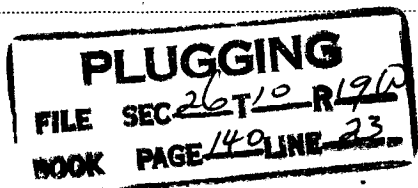

LEASE: Smith #1  
 OWNER: J. A. Allison et al  
 CONTRACTOR: Karl F. Wakefield  
 COMN: 8-7-47 COMP: 8-22-47

LOCATION: NE SW SW of 26-10-19  
 Rooks County, Kansas  
 CASING : 12 1/4 185  
 5 1/2 3566.97

Post Rock	52
Shale & Shells	175
Shale	330
Shale & Shells & Sand	375
Shale & Sand	790
Gyp & Shale	880
Shale & Sand	1140
Red Bed	1160
Red Bed & Shale	1403
Anhydrite	1460
Shale & Shells	1810
Shale & Salt	1930
Shale & Shells	2015
Shale & Lime	2105
Sandy Lime & Shale	2195
Lime & Shale	2840
Shale	2870
Lime	2895
Sandy Shale	2908
Lime	2912
Lime & Shale	3061
Lime	3109
Lime & Shale	3227
Lime (Cherty)	3241
Lime & S. ale	3259
Lime	3305
Shale	3315
Lime	3546
Lime & Shale	3580
Conglomerate	3656
Lime & Shale	3660
Arbuckle Lime	3694
T. D.	3694

STATE OF KANSAS )  
 COUNTY OF SEDGWICK ) SS

I hereby certify that the above is a true and correct copy of  
 the log of the Smith #1 well located in the NW SE SW of 26-10-19  
 Rooks County, Kansas

Earl F. Wakefield

Subscribed and sworn to before me this 28th day of August 1947

B. Jeanne Gaffney

My Commission Expires: 12-23-50

PLUGGING  
 FILE SEC 26T-10R-19W  
 BOOK PAGE 149 LINE 23

15-163-02375-0000



STATE OF KANSAS  
STATE CORPORATION COMMISSION

CONSERVATION DIVISION

800 BITTING BUILDING

WICHITA, KANSAS

October 15, 1947

IN REPLY PLEASE  
REFER TO THIS  
SUBJECT

A.D. Allison  
716 Brown Bldg.  
Wichita, Kansas

Dear Sir:

IN ACCOUNT WITH Conservation Division, State Corporation Commission

Wichita, Kansas

WE Charge YOU

Plugging Assessment.....\$ 25.00

Well No. 1  
Farm Smith-Holderman  
Description NE SW SW 26-10-19W  
County Rooks  
File: 140-23

The assessment for the plugging of all wells in the State of Kansas is one cent per foot, with a maximum of \$25.00 and a minimum of \$5.00.

This assessment will be past due November 15, 1947

PLEASE RETURN ONE COPY WITH REMITTANCE

NOTE: We also need a written Application, Well Log and Well Plugging Record on this well to complete our file.

#58  
*Paid*  
11-5-47  
JB