

15-163-02378-0000

STATE OF KANSAS
STATE CORPORATION COMMISSION


WELL PLUGGING RECORD

Give All Information Completely
Make Required Affidavit
Mail or Deliver Report to:
Conservation Division
State Corporation Commission
800 Bitting Building
Wichita, Kansas

OR
FORMATION PLUGGING RECORD

Strike out upper line
when reporting plug-
ging off formations.

NORTH

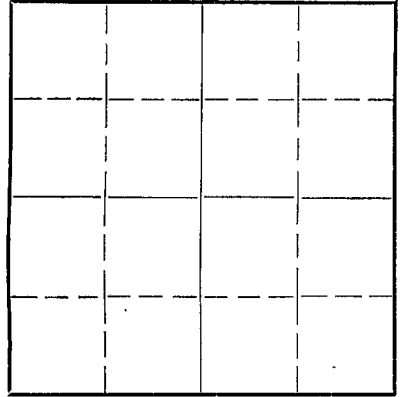

Locate well correctly on above
Section Plat

ROOKS

County. Sec. 26 Twp. 10S Rge. 19W (E) (W)

Location as "NE $\frac{1}{4}$ NW $\frac{1}{4}$ SW $\frac{1}{4}$ " or footage from lines. Cen. W $\frac{1}{2}$ NW $\frac{1}{4}$ SE $\frac{1}{4}$

Lease Owner The Aylward Production Company

Lease Name Johnson "A" Well No. 3

Office Address 813 First Natl. Bank Bldg., Wichita, 2, Kansas.

Character of Well (completed as Oil, Gas or Dry Hole) Dry

Date well completed September 3, 1946. 19

Application for plugging filed September 3, 1946. 19

Application for plugging approved September 10, 1946. 19

Plugging commenced September 7, 1946. 19

Plugging completed September 10, 1946. 19

Reason for abandonment of well or producing formation.

If a producing well is abandoned, date of last production. 19

Was permission obtained from the Conservation Division or its agents before plugging was commenced? Yes

Name of Conservation Agent who supervised plugging of this well H. W. Kerr

Producing formation. Depth to top. Bottom. Total Depth of Well. 3660 Feet

Show depth and thickness of all water, oil and gas formations.

OIL, GAS OR WATER RECORDS

CASING RECORD

Formation	Content	From	To	Size	Put In	Pulled Out
				8"	1241'	None
				5 $\frac{1}{2}$ "	3561'	2275'

Describe in detail the manner in which the well was plugged, indicating where the mud fluid was placed and the method or methods used in introducing it into the hold. If cement or other plugs were used, state the character of same and depth placed, from feet to feet for each plug set.

Set Lane Wells Plug at 3500'
" " " " " 3300'
" " " " " 3100'

Filled hole with mud to 350' by pump.
Placed bridge at 350', placed 15 sacks
cement on bridge with dump bailer.
Filled with mud to 25' placed bridge and
filled with cement to cellar.

SEP 26 10 1946
SEP 7 0 1946

(If additional description is necessary, use BACK of this sheet)

Correspondence regarding this well should be addressed to 813 First Natl. Bank Bldg.
Address Wichita, Kansas. The Aylward Production Company

STATE OF KANSAS, COUNTY OF SEDGWICK, ss.

J. W. Hummel (employee of owner) or (owner or operator) of the above-described well,
being first duly sworn on oath, says: That I have knowledge of the facts, statements, and matters herein contained and the log of the above-
described well as filed and that the same are true and correct. So help me God.

(Signature) J. W. Hummel
(Address) 9-26-46

SUBSCRIBED AND SWORN to before me this 75 day of September 1946

My commission expires January 19, 1947

Alfred J. Spolsky
Notary Public.

Casing Record:

6" - 1241'
 5 1/2" - 3561'

Company: The Aylward Production Co.
 Contractor: Aylward Drilling Company

Commenced: August 12, 1946
 Completed: September 10, 1946

Description:
 Gen. W/2 NW/4 SE/4
 Sec. 25-10N-19W,
 Rooks County, Kansas
 Elevation: 2946'
 Potential: Dry

<u>Formation</u>	<u>From</u>	<u>To</u>	<u>Remarks</u>
Sand & Shale	0	200	
Shale, Sticky	200	300	
Shale	300	480	
Shale & Sand	480	500	
Shale & Shells	500	830	
Sand	830	1000	
Lime & Sand	1000	1160	
Shells & Red Bed	1160	1241	Set 6" at 1241'
Red Bed & Shale	1241	1385	Cemented with 300 Sacks
Anhydrite	1385	1415	
Shale & Lime Shells	1415	1640	
Shale & Shells	1640	1850	
Salt & Shale Shells	1850	1915	
Shale & Shells	1915	2032	
Lime & Shale	2032	2122	
Shale & Shells	2122	2190	
Lime	2190	2500	
Lime & Shale	2500	2740	
Shale & Shells	2740	2870	
Broken Lime	2870	2900	
Shale	2900	2967	
Lime	2967	3075	
Lime, Broken	3075	3140	
Lime	3140	3240	
Lime & Shale	3240	3328	Circulated 1 hr. @ 3305
Lime	3328	3404	Slight odor
Lime & Shale	3404	3504	
Lime & Shat	3504	3515	
Lime & Shale	3515	3545	
Shale	3545	3555	
Lime	3555	3566	Circulated 1 hr @ 3560 for samples Set 5 1/2" @ 3561', Cemented with 175 Sacks

T. D. 3504'

Set Lane-Well plug @ 3501'
 Shot W/12 Shots 3310-3298'
 Set Lane-Well plug @ 3296'
 Shot W/12 Shots 3298-3281 - Some water, no oil
 " " " 3275-3265 - N.F.W. show oil
 Set Lane-Well plug @ 3104'
 Shot W/6 shots 3002-2997' - 2 1/2 B.W.P.H. - show oil
 " " " 2991-2996 - Dry
 " " " 3002 to 3007 - No increase
 30 Gal oil in 8 hrs.
 300' of water

PLUGGING	
FILE	26 10 1946
BOOK	PAGE 20
	19

I hereby certify that this is a true and correct copy of the above log to the best of my knowledge.

[Signature]

Subscribed and sworn to before me this 19th day of September, 1946.

[Signature]

My commission expires: February 25, 1946

15-163-02378-0000



STATE OF KANSAS
STATE CORPORATION COMMISSION
CONSERVATION DIVISION
800 BITTING BUILDING
WICHITA, KANSAS

October 1, 1946

IN REPLY PLEASE
REFER TO THIS
SUBJECT

The Aylward Production Co.
818 First National Bank Bldg.
Wichita 2, Kansas

IN ACCOUNT WITH Conservation Division, State Corporation Commission
Wichita, Kansas

WE Charge YOU

Plugging Assessment.....\$ 25.00

Pd.
10/5/46
Ha

Well No. 3
Farm Johnson "A"
Description C W $\frac{1}{2}$ NW SE 26-10-19W
County Rocks
File: 70-19

The assessment for the plugging of all wells in the State of Kansas is one cent per foot, with a maximum of \$25.00 and a minimum of \$5.00.

This assessment will be past due October 11, 194 6

PLEASE RETURN ONE COPY WITH REMITTANCE

NOTE: We also need a log of this well, to complete the file.

I attach
file

