


STATE OF KANSAS
STATE CORPORATION COMMISSION

Give All Information Completely
Make Required Affidavit
Mail or Deliver Report to:
Conservation Division
State Corporation Commission
800 Bittling Building
Wichita, Kansas

WELL PLUGGING RECORD

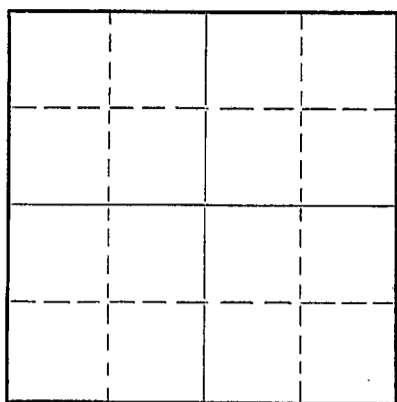

Locate well correctly on above
Section Plat

Rooks County. Sec. 26 Twp. 10 Rge. (E) 19 (W)
Location as "NE/CNW 1/4 SW 1/4" or footage from lines SE SW SE
Lease Owner Perry - Brown - Veeder Supply Company
Lease Name Johnson Well No. A-1
Office Address P. O. Box 201, Cherryvale, Kansas
Character of Well (completed as Oil, Gas or Dry Hole) Dry Hole
Date well completed September 24, 19 51
Application for plugging filed September 24, 19 51
Application for plugging approved September 24, 19 51
Plugging commenced September 24, 19 51
Plugging completed September 24, 19 51
Reason for abandonment of well or producing formation

If a producing well is abandoned, date of last production 19
Was permission obtained from the Conservation Division or its agents before plugging was commenced? Yes

Name of Conservation Agent who supervised plugging of this well Eldon Petty, Hays, Kansas
Producing formation Depth to top Bottom Total Depth of Well 3660' Feet
Show depth and thickness of all water, oil and gas formations.

OIL, GAS OR WATER RECORDS

CASING RECORD

Formation	Content	From	To	Size	Put In	Pulled Out
				217'	8-5/8"	Cemented

Describe in detail the manner in which the well was plugged, indicating where the mud fluid was placed and the method or methods used in introducing it into the hole. If cement or other plugs were used, state the character of same and depth placed, from feet to feet for each plug set.

Mud from 3660 to 200' Plug set @ 200' with 1/2 sack hulls and 15 sacks cement on top of plug. Mud to 40' Set plug at 40' and 1/2 sack hulls and 10 sacks cement on top of plug. This cemented to top of surface.

10-2-51

(If additional description is necessary, use BACK of this sheet)

Correspondence regarding this well should be addressed to The Veeder Supply & Development Co.
Address P.O. Box 201
Cherryvale, Kansas

STATE OF KANSAS, COUNTY OF MONTGOMERY, ss.
LEO C. VEEDER (employee of owner) or (owner or operator) of the above-described well,

being first duly sworn on oath, says: That I have knowledge of the facts, statements, and matters herein contained and the log of the above-described well as filed and that the same are true and correct. So help me God. THE VEEDER SUPPLY & DEVELOPMENT COMPANY

(Signature) Leo C. Veeder, Vice-Pres

P. O. Box 201, Cherryvale, Kansas (Address)

SUBSCRIBED AND SWORN TO before me this 29th day of September 19 51

Gleo Lawson Notary Public

My commission expires July 11, 1952

PLUGGING
FILE SEC 26 T 10 R 19W
BOOK PAGE 112 LINE 3

15-163-04069-0000

Company B.L. Perry-D.R. Brown-Veeder Supply Co.

Sec. 26 T. 10S R. 19W

Loc. Southeast Quarter

County Rooks County, Kansas

Farm Johnson

No. A-1

Total Depth 3660'

Comm. 9-13-51


Comp. 9-24-51

Shot or Treated

Contractor Veeder Supply Company Drilled with Rig - A

Issued No. of Days - 12

No. of Bits -

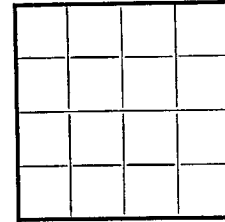

Casing

20 in.	10 in
15 1/2	8 1/4
12 1/2	6 5/8
13 3/8	5 3/16

217' of 8-5/8" Cemented with 150 sacks

Elevation cement.

Production

Figures Indicate Bottom of Formation

Soil Lime Stone	0	55	55
Lime Stone	55	75	20
Blue Shale	75	182	107
Lime Shale	182	217	35
Shale	217	425	208
Sandy Shale	425	690	265
Shale Shells	690	875	185
Sand	875	1080	205
Shale Shells	1080	1408	328
Anhydrite	1408	1440	32
Shale Lime Shells	1440	1695	255
Shale Shells	1695	2315	620
Shale Lime	2315	2335	20
Lime Shale	2335	2565	230
Lime Shells Shale	2565	2785	220
Shale Shells	2785	2915	130
Shale Lime	2915	2975	60
Lime Shale	2975	3060	85
Lime	3060	3555	495
Conglomerate	3555	3615	60
Conglomerate Chert	3615	3660	45
Total Depth	3660'		

RECEIVED
 STATE CORPORATION COMMISSION
 OCT X 2 1951
 CONSERVATION DIVISION
 Wichita, Kansas

PLUGGING
 FILE SEC 26 T 10 R 19W
 BOOK PAGE 118 LINE 30