

15-163-20857-0000


STATE OF KANSAS
STATE CORPORATION COMMISSION

WELL PLUGGING RECORD

Give All Information Completely
Make Required Affidavit
Mail or Deliver Report to
Conservation Division
State Corporation Comm.
245 North Water
Wichita, KS 67202

Rooks County, Sec. 27 Twp. 10s Rge. 19W K/W
Location as "NE/CNW/SW" or footage from lines
NE SE NW

Lease Owner Tomlinson Oil Co., Inc.
Lease Name Boy's Home Well No. 1
Office Address Suite 1030, 200 W. Douglas, Wichita, KS
Character of Well (Completed as Oil, Gas or Dry Hole)
Dry Hole

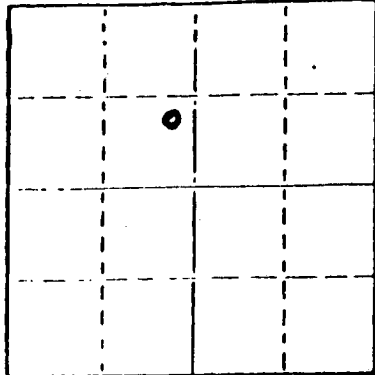

Locate well correctly on above
Section Plat

Date Well completed 12-18-78 19
Application for plugging filed 12-18-78 19
Application for plugging approved 12-18-78 19
Plugging commenced 12-18-78 19
Plugging completed 12-18-78 19
Reason for abandonment of well or producing formation
Dry Hole

If a producing well is abandoned, date of last production
N/A 19

Was permission obtained from the Conservation Division or
its agents before plugging was commenced? yes

Name of Conservation Agent who supervised plugging of this well Leo F. Massey
Producing formation _____ Depth to top _____ Bottom _____ Total Depth of Well 3671
Show depth and thickness of all water, oil and gas formations.

OIL, GAS OR WATER RECORDS

CASING RECORD

FORMATION	CONTENT	FROM	TO	SIZE	PUT IN	PULLED OUT
Sand, Clay, Shale				8 5/8"	210'	None

Describe in detail the manner in which the well was plugged, indicating where the mud fluid was placed and the method or methods used in introducing it into the hold. If cement or other plugs were used, state the character of same and depth placed, from _____ feet to _____ feet for each plug set.

Plugged:	70 sx	720'				
	20 sx	185'				
	10 sx	40'				
	2 sx	RH				
	50-50	PAZ	6% gel			

RECEIVED
STATE CORPORATION COMMISSION
12-22-78
DEC 22 1978

CONSERVATION DIVISION
Wichita, Kansas

(If additional description is necessary, use BACK of this sheet)

Name of Plugging Contractor Sun OilWell Cementing

STATE OF Kansas COUNTY OF Sedgwick, ss.
Paul A. Seymour, Jr. (employee of owner) or (owner or operator)

of the above-described well, being first duly sworn on oath, says: That I have knowledge of the facts, statements, and matters herein contained and the log of the above-described well as filed and that the same are true and correct. So help me God.

(Signature) Paul A. Seymour, Jr.
Box 8287, Munger Station, Wichita, KS
(Address)

SUBSCRIBED AND SWORN TO before me this 21st day of December, 1978

Ruth M. Bassett
Ruth M. Bassett Notary Public.

My commission expires May 30, 1979



15-163-20887-0000

BIG SPRINGS DRILLING, INC.

P.O. BOX 8287
MUNGER STATION
WICHITA, KANSAS 67208

SUITE 29 • 400 NORTH WOODLAWN • (316) 681-1732

December 21, 1978

DRILLERS LOG

Re: Boy's Home
NE SE NW
Sec. 27 - Twp 10s - Rq 19W
Rooks County, Kansas

OPERATOR: Tomlinson Oil Co., Inc.
CONTRACTOR: Big Springs Drilling, Inc.
COMMENCED: 12-11-78
COMPLETED: 12-18-78

Surface Pipe: 210' of 8 5/8" w/160 sx Common 2% g

0	210	Clay, Shale and Sand
210	1450	Shale and RedBed
1450	1482	Anhydrite
1482	2119	Shale
2119	3110	Shale and Lime
3110	3671	Lime
3671		RTD

RECEIVED
STATE CORPORATION COMMISSION
DEC 22 1978
CONSERVATION DIVISION
Wichita, Kansas

We certify that the above and foregoing is a true and correct copy of the log on the # 1 Boy's Home located in Rooks County, Kansas.

BIG SPRINGS DRILLING, INC.


Paul A. Seymour, Jr.

Subscribed and sworn to before me this 21st day of December, 1978.


Ruth M. Bassett Notary Public

My Commission Expires:

May 30, 1979

