

WELL PLUGGING RECORD

NORTH

	Sec. 29		
	O		

Locate well correctly on above
Section Plat

ROOKS County. Sec. 29 Twp. 10 Rge. 19 (NW) W(W)
Location as "NE/CNW/SW" or footage from lines NE NE SW
Lease Owner PETROLEUM, INC.
Lease Name DICK "B" Well No. 1
Office Address ROUTE 2, GREAT BEND, KANSAS
Character of Well (completed as Oil, Gas or Dry Hole) DRY HOLE
Date well completed December 29, 1957
Application for plugging filed December 30, 1957
Application for plugging approved January 2, 1958
Plugging commenced December 29, 1957
Plugging completed December 29, 1957
Reason for abandonment of well or producing formation
No Producing Zones
If a producing well is abandoned, date of last production None 19
Was permission obtained from the Conservation Division or its agents before plugging was commenced? Yes

Name of Conservation Agent who supervised plugging of this well Eldon Petty, Box 326, Hays, Kansas
Producing formation ----- Depth to top ----- Bottom ----- Total Depth of Well 3765' Feet
Show depth and thickness of all water, oil and gas formations.

OIL, GAS OR WATER RECORDS

CASING RECORD

FORMATION	CONTENT	FROM	TO	SIZE	PUT IN	PULLED OUT
				8-5/8"	253.95'	None

Describe in detail the manner in which the well was plugged, indicating where the mud fluid was placed and the method or methods used in introducing it into the hole. If cement or other plugs were used, state the character of same and depth placed, from ----- feet to ----- feet for each plug set.

Mud up with heavy mud to 540' followed by wooden plug. Placed 20 sacks cement through drill pipe on to plug. Mud up to 40' and placed 1/2 sack hulls at 40' followed by wooden plug and 15 sacks cement to base of well cellar.

1-9-58

(If additional description is necessary, use BACK of this sheet)
Name of Plugging Contractor GARVEY DRILLING COMPANY
Address ROUTE 2, GREAT BEND, KANSAS


STATE OF KANSAS, COUNTY OF BARTON, ss.
Don Searle (employee of owner) or (owner or operator) of the above-described well, being first duly sworn on oath, says: That I have knowledge of the facts, statements, and matters herein contained and the log of the above-described well as filed and that the same are true and correct. So help me God.

(Signature) Don Searle
Route 2, Great Bend, Kansas
(Address)

SUBSCRIBED AND SWORN TO before me this 8th day of January, 1958

My commission expires July 11, 1960

Notary Public.

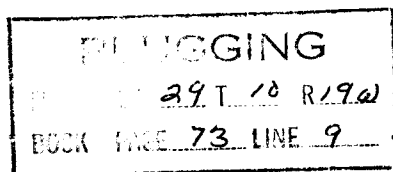

WELL LOG

15-163-02575-0000

COMPANY PETROLEUM, INCORPORATED

SEC. 29 T. 10S R. 19W

FARM DICK "B"X NO. 1

LOC. NE, NE, SW


TOTAL DEPTH 3765'

COUNTY ROOKS CO., KANSAS

COMM. December 17, 1957 COMP. December 29, 1957

CONTRACTOR GARVEY DRILLING COMPANY

CASING 8 5/8" @ 253.95' W/230 sax.

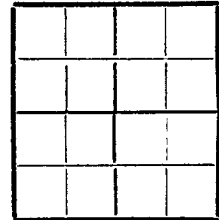

ELEVATION 2191' DF

PRODUCTION D & A


FIGURES INDICATE BOTTOM OF FORMATIONS

120	Sand & clay
355	Blue shale
765	Shale & shells
1320	Sand
1586	Shale
1625	Anhydrite
1820	Shale
2170	Shale & shells
3200	Lime & shale
3740	Lime
3752	Simpson
3765	Arbuckle
3765	T. D.

State of KANSAS

County of BARTON

ss:

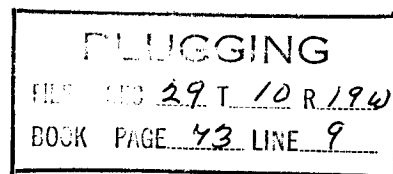

I, VERNE A. MORRIS of GARVEY DRILLING CO.

upon oath state that the above and foregoing is a true and correct copy of the log of the #1 DICK "B" well

Subscribed and sworn to before me this 7th day of January 19 58

My Commission Expires: July 11, 1960

NOTARY PUBLIC