

STATE OF KANSAS STATE CORPORATION COMMISSION

Give All Information Completely Make Required Affidavit Mail or Deliver Report to: Conservation Division State Corporation Commission 212 No. Market Wichita, Kansas

WELL PLUGGING RECORD

Rooks County. Sec. 30 Twp. 10S Rge. 19W (E) (W)

Location as "NE/CNW%SW%" or footage from lines C SW/4

Lease Owner Alpine Oil & Royalty Co., Inc.

Lease Name Schonthaler Well No. 2

Office Address 800 Bitting Building, Wichita, Kansas 67202

Character of Well (completed as Oil, Gas or Dry Hole) dry hole

Date well completed June 11, 1968 19

Application for plugging filed June 11, 1968 (by phone) 19

Application for plugging approved June 11, 1968 (by phone) 19


Plugging commenced June 11, 1968 19

Plugging completed June 11, 1968 19

Reason for abandonment of well or producing formation nonproductive in commercial quantities

If a producing well is abandoned, date of last production 19

Was permission obtained from the Conservation Division or its agents before plugging was commenced? Yes

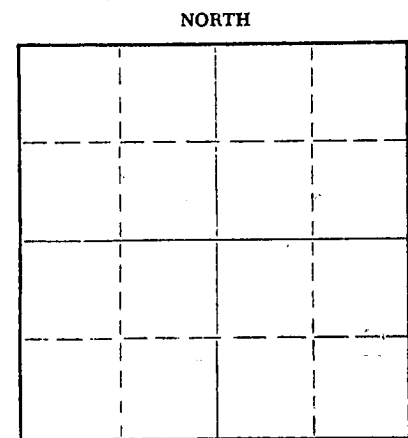

Locate well correctly on above Section Plat

Name of Conservation Agent who supervised plugging of this well Leo Massey

Producing formation Depth to top Bottom Total Depth of Well Feet

Show depth and thickness of all water, oil and gas formations.

OIL, GAS OR WATER RECORDS

CASING RECORD

Table with 7 columns: FORMATION, CONTENT, FROM, TO, SIZE, PUT IN, PULLED OUT. One entry shows size 8 5/8" and put in 221' with note 'cemented'.

Describe in detail the manner in which the well was plugged, indicating where the mud fluid was placed and the method or methods used in introducing it into the hole. If cement or other plugs were used, state the character of same and depth placed, from feet to feet for each plug set.

Heavy mud from total depth to 800 feet; plug and 70 sacks cement; second plug at 210 feet with 20 sacks; bridge at 40 feet with plug and 1/2 sacks hulls and 10 sacks cement to bottom of cellar; 2 sacks cement for rat hole

RECEIVED STATE CORPORATION COMMISSION JUN 14 1968 CONSERVATION DIVISION Wichita, Kansas

(If additional description is necessary, use BACK of this sheet)

Name of Plugging Contractor Gabbert-Jones, Inc.

Address 830 Sutton Place, Wichita, Kansas 67202

STATE OF Kansas, COUNTY OF Sedgwick, ss.

Dwight J. Wilson (employee of owner) or (owner or operator) of the above-described well, being first duly sworn on oath, says: That I have knowledge of the facts, statements, and matters herein contained and the log of the above-described well as filed and that the same are true and correct. So help me God.


(Signature) Dwight J. Wilson

800 Bitting Bldg., Wichita, Kansas (Address)

SUBSCRIBED AND SWORN to before me this 14 day of June 1968

Evelyn Wanko Notary Public.

My commission expires December 10, 1968

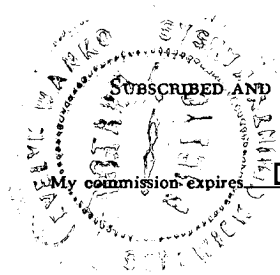

GABBERT-JONES, INC.
 WICHITA, KANSAS
 DRILLERS' WELL LOG

SCHONTHALER #2
 C SW $\frac{1}{4}$ SECTION 30-10S-19W
 ROOKS COUNTY, KANSAS

COMMENCED: JUNE 3, 1968
 COMPLETED: JUNE 11, 1968

OPERATOR - ALPINE OIL & ROYALTY Co., Inc.

DEPTH		FORMATION	REMARKS
FROM	TO		
0	55	SHALE	
55	85	SAND	
85	221	SHALE AND SHELLS	RAN 6 JOINTS 8-5/8" CASING, SET @ 221' w/165 SACKS CEMENT.
221	900	SHALE AND SHELLS	
900	1100	SHALE	
1100	1315	SAND	
1315	1410	SHALE	
1410	1634	RED BED AND SHALE	
1634	1674	ANHYDRITE	
1674	1765	SHALE AND SHELLS	
1765	2195	SHALE AND SALT	
2195	2354	LIME	
2354	3420	LIME AND SHALE	
3420	3458	LIME	
3458	3480	SHALE AND LIME	
3480	3696	LIME	
3696	3736	LIME AND SHALE	
3736	3780	CONGLOMERATE AND CHERT	
3780	3810	LIME AND CHERT	
3810	3855	LIME	
3855	TD		DRY AND ABANDONED.

RECEIVED
 STATE CORPORATION COMMISSION
 JUN 14 1968
 CONSERVATION DIVISION
 Wichita, Kansas

I, E. E. HALL, CERTIFY THIS IS A CORRECT COPY OF THE DRILLERS' LOG FOR THE WELL DRILLED IN THE C SW $\frac{1}{4}$ SECTION 30-10S-19W, ROOKS COUNTY, KANSAS, TO THE BEST OF MY KNOWLEDGE AND BELIEF.

E. E. Hall
 E. E. HALL

STATE OF KANSAS)
) SS
 COUNTY OF SEDGWICK)

BEFORE ME, THE UNDERSIGNED, A NOTARY PUBLIC WITHIN AND FOR SAID COUNTY AND STATE, ON THIS 13TH DAY OF JUNE, 1968, PERSONALLY APPEARED E. E. HALL, TO ME PERSONALLY KNOWN TO BE THE IDENTICAL PERSON WHO EXECUTED THE WITHIN AND FOREGOING INSTRUMENT AND ACKNOWLEDGED TO ME THAT HE EXECUTED THE SAME AS HIS FREE AND VOLUNTARY ACT AND DEED FOR THE USES AND PURPOSES THEREIN SET FORTH.

IN WITNESS WHEREOF, I HAVE HEREUNTO SET MY HAND AND OFFICIAL SEAL THE DAY AND

Barbara J. Layton
 BARBARA J. LAYTON, NOTARY PUBLIC

My Commission Expires February 1, 1972.

