

WELL PLUGGING RECORD

Give All Information Completely
Make Required Affidavit
Mail or Deliver Report to
Conservation Division
State Corporation Comm.
200 Colorado Derby Bldg.
202 W. 1st St.
Wichita, KS 67202

Rooks County Sec. 30 Twp. 10s Rge. 19
Location as "NE/CNW/SW" or footage from lines

SW SW NW
Lease Owner Isern-Schultz Oil & Gas Inc.

Lease Name Keller Well No. #1

Office Address Box 486 Ellinwood, Ks 67526

Character of Well (Completed as Oil, Gas or Dry Hole)
Dry Hole

Date Well completed October 9 19 81

Application for plugging filed October 9 19 81

Application for plugging approved October 9 19 81

Plugging commenced 7:45 P.M. October 9 19 81

Plugging completed 8:45 P.M. October 9 19 81


Reason for abandonment of well or producing formation
No Commercial Production

If a producing well is abandoned, date of last production
19

Was permission obtained from the Conservation Division or
its agents before plugging was commenced? Yes

Name of Conservation Agent who supervised plugging of this well Marion Schmidt
Producing formation Depth to top Bottom Tl. Depth of Well
Show depth and thickness of all water, oil and gas formations.

locate well correctly
on above
Section Plot

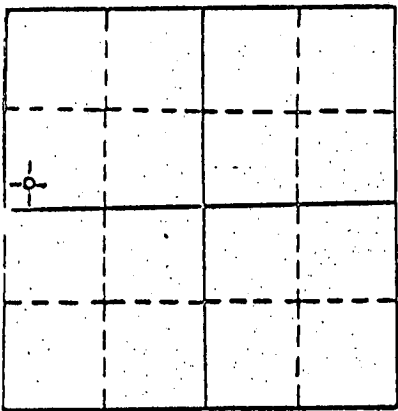

OIL, GAS OR WATER RECORDS

CASING RECORD

FORMATION	CONTENT	FROM	TO	SIZE	PUT IN	PULLED OUT
Surface Casing	common	0'	242.44'	8 5/8"	242.44'	0'

Describe in detail the manner in which the well was plugged, indicating where the mud fluid was placed and the method or methods used in introducing it into the hold. If cement or other plugs were used, state the character of same and depth placed, from feet to feet for each plug set.

STATE RECEIVED
4-14-82
APR 14 1982
CONSERVATION DIVISION
Wichita, Kansas

Plug #1 900' with 70sxs
Plug #2 240' with 40sxs
Plug #3 40' with 10sxs
10sxs in rathole
Total-----130sxs 50-50pos 6%gel
P.D. @ 8:45 P.M.

(If additional description is necessary, use BACK of this sheet)

Name of Plugging Contractor Pioneer Drilling Co.
308 West Mill Plainville, Ks 67663

STATE OF Kansas COUNTY OF Barton ss.
Willie E. Schultz President of Isern-Schultz Oil & Gas Inc
employee or owner or (owner or operator) of the
above described well, being first duly sworn on oath, says: That I have knowledge of the
facts, statements, and matters herein contained and the log of the above described well
is filed and that the same are true and correct. So help me God.

(Signature) Willie E. Schultz pres.
(Address) Box 486 Ellinwood, Ks

SUBSCRIBED AND SWORN TO before me this 24th day of March, 1982

JERRY KASSELIAN
STATE NOTARY PUBLIC
Barton County, Kansas

Jerry Kasselian

15-163-21404-0000

W E L L L O G

OPERATOR: Isern-Schultz Oil & Gas Inc.

WELL NAME: Keller #1 LOCATION: SW SW NW 30-10s-19W

COUNTY: Rooks STATE: Kansas

WELL COMMENCED: September 30, 1981 WELL COMPLETED: October 9, 1981

ELEVATION: 2225' K.B. TOTAL DEPTH: 3794'

PRODUCTION: D & A RIG NO: #2

CASING - 8 5/8": 6 Jts new 20# set@ 242.44' cemented with 165 sxs common 2%gel 3%cc
P.D.@ 1:45 A.M. 10-1-81 did circ.
5 1/2": _____

ALL MEASUREMENTS TAKEN FROM THE TOP OF ROTARY BUSHING:

FROM	TO	FORMATION	DEVIATION FROM VERTICAL	REMARKS:
0'	186'	sand and shale		
186'	250'	sand and shale	250' - 1/4 degree	
250'	990'	sand and shale		
990'	1614'	sand and shale		
1614'	1630'	anhydrite		
1630'	1653'	anhydrite		
1653'	1870'	shale and sand	1665' - 1 1/4 degree	
1870'	2330'	sand and shale		
2330'	2450'	lime and shale	2450' - 0 degree	
2450'	2500'	lime and shale		
2500'	2760'	lime and shale		
2760'	2950'	lime and shale		
2950'	3080'	sand and shale		
3080'	3210'	lime and shale		
3210'	3265'	lime and shale	3265' - 1/2 degree	
3265'	3370'	lime and shale		
3370'	3470'	lime and shale		
3470'	3556'	lime and shale		
3556'	3626'	lime and shale		
3626'	3705'	lime and shale		
3705'	3785'	lime and shale		
3785'	3790'	arbuckle		
3790'	3794'	arbuckle		
3794'	R.T.D.			

RECEIVED
STATE CORPORATION COMMISSION
APR 14 1982
CONSERVATION DIVISION
Wichita, Kansas

STATE OF KANSAS
COUNTY OF _____

The undersigned hereby certifies that to the best of his knowledge and belief, the above facts are true and correct.

PIONEER DRILLING CO., INC.
By Stacy A. Hilgus

SUBSCRIBED AND SWORN TO, BEFORE ME, This 16th day of October, 1981

Sharon Garvert
NOTARY PUBLIC

SHARON GARVERT
NOTARY PUBLIC
STATE OF KANSAS
My Appt. Expires 10/24/84