


Give All Information Completely
Make Required Affidavit
Mail or Deliver Report to:
Conservation Division
State Corporation Commission
211 No. Broadway
Wichita, Kansas

WELL PLUGGING RECORD

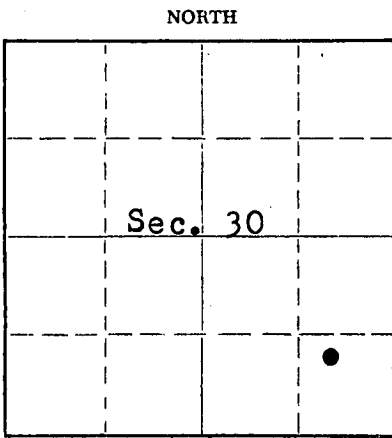

Locate well correctly on above Section Plat

ROOKS County. Sec. 30 Twp. 19 Rge. 19 (NW SE SE) W(W)
Location as "NE/CNW/SE/SW" or footage from lines _____
Lease Owner PETROLEUM, INC.
Lease Name KELLER "D" Well No. 1
Office Address ROUTE 2, GREAT BEND, KANSAS
Character of Well (completed as Oil, Gas or Dry Hole) DRY HOLE
Date well completed February 28, 19 58
Application for plugging filed March 3, 19 58
Application for plugging approved March 5, 19 58
Plugging commenced March 6, 19 58
Plugging completed March 6, 19 58
Reason for abandonment of well or producing formation No Produccible Zones
If a producing well is abandoned, date of last production None 19 _____
Was permission obtained from the Conservation Division or its agents before plugging was commenced? Yes

Name of Conservation Agent who supervised plugging of this well Eldon Petty, Hays, Kansas
Producing formation _____ Depth to top _____ Bottom _____ Total Depth of Well 3758 Feet
Show depth and thickness of all water, oil and gas formations.

OIL, GAS OR WATER RECORDS

CASING RECORD

FORMATION	CONTENT	FROM	TO	SIZE	PUT IN	PULLED OUT
				8-5/8"	276'	None

Describe in detail the manner in which the well was plugged, indicating where the mud fluid was placed and the method or methods used in introducing it into the hole. If cement or other plugs were used, state the character of same and depth placed, from _____ feet to _____ feet for each plug set.

Mud up with heavy mud to 540' followed by wooden plug. Placed 20 sacks ~~more~~ cement through drill pipe on to plug. Mud up to 240' followed by wooden plug. Placed 15 sacks cement through drill pipe on to plug. Mud up to 35', pushed down 1/3 sack hulls to 35' followed by wooden plug and 10 sacks cement to base of well cellar.

3-17-58

Conservation Division
Wichita, Kansas

(If additional description is necessary, use BACK of this sheet)
Name of Plugging Contractor GARVEY DRILLING COMPANY
Address ROUTE 2, GREAT BEND, KANSAS

STATE OF KANSAS, COUNTY OF BARTON, ss.
Don Searle (employee of owner) or (~~owner~~) of the above-described well, being first duly sworn on oath, says: That I have knowledge of the facts, statements, and matters herein contained and the log of the above-described well as filed and that the same are true and correct. So help me God.

(Signature) Don Searle
Route 2, Great Bend, Kansas
(Address)

SUBSCRIBED AND SWORN TO before me this 13th day of March 19 58
Jed T. Brown
Notary Public.

My commission expires July 11, 1960

PLUGGING
REC 39 10 R 194
BOOK PAGE 86 LINE 71

WELL LOG 15-163-00747-0000

COMPANY PETROLEUM, INCORPORATED

SEC. 30 T. 10S R. 19W

FARM KELLER "D" NO. 1


LOC. NW, SE, SE

TOTAL DEPTH 3758'

COUNTY ROOKS CO., KANSAS

COMM. February 18, 1958 COMP. March 6, 1958

CONTRACTOR GARVEY DRILLING COMPANY

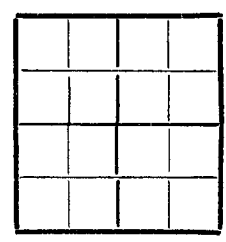

CASING 8 5/8" @ 276' W/175 sax.

ELEVATION 2181' DF

PRODUCTION D & A

FIGURES INDICATE BOTTOM OF FORMATIONS

75	Sand & clay
276	Shale & shells
665	Shale
1345	Shale & sand
1590	Shale & shells
1610	Anhydrite
1920	Shale & shells
2125	Shale
2490	Shale & lime
2540	Lime
3190	Shale & lime
3264	Lime
3340	Lime & shale
3400	Lime
3420	Lime & shale
3460	Lime & chert
3654	Lime
3710	Lime & shale
3755	Lime, chert & shale
3758	Lime
3758	T. D.

RECEIVED
STATE OF KANSAS

MAR 17 1958

CONSERVATION DIVISION
Wichita, Kansas

PLUGGING
FILE SEC 30 T. 10 R. 19 W
BOOK PAGE 86 LINE 41

State of KANSAS
County of BARTON } ss:

I, VERNE A. MORRIS of GARVEY DRILLING COMPANY

upon oath state that the above and foregoing is a true and correct copy of the log of the #1 KELLER "D" well

Verne A. Morris

Subscribed and sworn to before me this 12th day of March 19 58

My Commission Expires: July 11, 1960

John J. Brown
NOTARY PUBLIC