

NOTICE OF INTENTION TO DRILL

(see rules on reverse side)

Starting Date 12.23.85 month day year

API Number 15- 163-22,837-0000 East

OPERATOR: License # 5205 Name Mid-Continent Energy Corporation Address 120 S. Market, Suite 310 City/State/Zip Wichita, KS 67202 Contact Person Bradley R. Buehler Phone (316) 265-9501

NW 1/4 SW 1/4 NE 1/4 Sec 8 Twp 10 S Rg 19 West 3630 Ft. from South Line of Section 2310 Ft. from East Line of Section

(Note: Locate well on Section Plat on reverse side)

CONTRACTOR: License # 5418 Name Allen Drilling Company City/State Great Bend, KS 67530

Nearest lease or unit boundary line 330 feet County Rooks

Lease Name Pekarek Well # 1 Ground surface elevation 2218 feet MSL

Well Drilled For: Well Class: Type Equipment: X Oil SWD Infield Mud Rotary Gas Inj Pool Ext Air Rotary OWWO Expl Wildcat Cable

Domestic well within 330 feet: yes X no Municipal well within one mile: yes X no Surface pipe by Alternate: 1 2 X

If OWWO: old well info as follows:

Depth to bottom of fresh water 1100 Depth to bottom of usable water 925 Surface pipe planned to be set 200' Projected Total Depth 3825 feet Formation Arbuckle

Operator Well Name Comp Date Old Total Depth

I certify that well will comply with K.S.A. 55-101, et seq., plus eventually plugging hole to KCC specifications.

Handwritten signature/initials

cementing will be done immediately upon setting production casing.

Date 12/3/85 Signature of Operator or Agent Karl R. Roberts Title Petroleum Geologist

For KCC Use:


Conductor Pipe Required feet: Minimum Surface Pipe Required feet per Alt. 1 2 This Authorization Expires 6-4-86 Approved By 12-4-85

Must be filed with the K.C.C. five (5) days prior to commencing well
This card void if drilling not started within six (6) months of date received by K.C.C.

Important procedures to follow:

1. Notify District office before setting surface casing.
 2. Set surface casing by circulating cement to the top.
 3. File completion forms ACO-1 with K.C.C. within 90 days of well completion, following instructions on ACO-1, side 1, and including copies of wireline logs.
 4. Notify District office 48 hours prior to old well workover or re-entry.
 5. Prior to filing Intent, prepare a proposed plugging plan in case well is D & A, then obtain approval of plan when calling district office prior to setting surface pipe.
 6. Submit plugging report (CP-4) to K.C.C. after plugging is completed.
 7. Obtain an approved injection docket number before disposing of salt water.
 8. Notify K.C.C. within 10 days when injection commences or terminates.
- alternate 2 completion, cement in the production pipe from below any usable water to surface within 120 days of spud date.

A Regular Section of Land 1 Mile = 5,280 Ft.

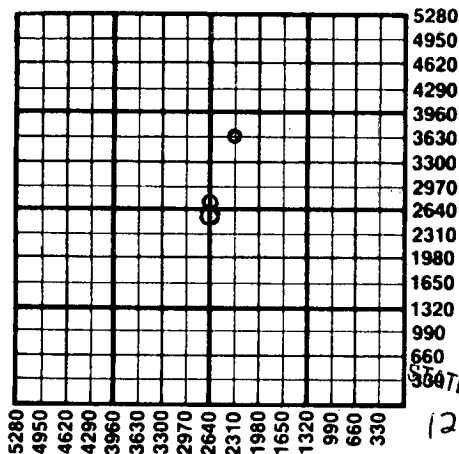

RECEIVED
STATE CORPORATION COMMISSION
12-4-85
DEC 4 1985

CONSERVATION DIVISION
Wichita, Kansas

State Corporation Commission of Kansas
Conservation Division
200 Colorado Derby Building
Wichita, Kansas 67202
(316) 263-3238