

CARD MUST BE TYPED

State of Kansas
NOTICE OF INTENTION TO DRILL
(see rules on reverse side)

CARD MUST BE SIGNED

Starting Date: September 25, 1985
month day year

API Number 15- 163-22,769-00-00

OPERATOR: License # 6194
Name ESP Development, Inc.

NW..SW..NW... Sec 2.. Twp 10.. S, Rge 18. East
(location) West

Address R.R. 1, Box 18

3630 Ft North from Southeast Corner of Section

City/State/Zip Paradise, KS 67658

4950 Ft West from Southeast Corner of Section

Contact Person Bud Eulert

(Note: Locate well on Section Plat on reverse side)

Phone (913) 998-4413

Nearest lease or unit boundary line 330 feet.

CONTRACTOR: License # 5783

County Rooks

Name Galloway Drilling Co., Inc.

Lease Name Collins Well# A-1

City/State Wichita, KS 67202

Domestic well within 330 feet: yes no

Well Drilled For: Well Class: Type Equipment:

- Oil Swd Infield Mud Rotary
- Gas Inj Pool Ext. Air Rotary
- OWWO Expl Wildcat Cable

Municipal well within one mile: yes no

If OWWO: old well info as follows:

Operator

Well Name

Comp Date Old Total Depth

Projected Total Depth 3700' feet

Projected Formation at TD Arbuckle

Expected Producing Formations Lansing/Arbuckle

Depth to Bottom of fresh water 100 feet

Lowest usable water formation Dakota

Depth to Bottom of usable water 950 feet

Surface pipe by Alternate: 1 2

Surface pipe to be set 250 feet

Conductor pipe if any required none feet

Ground surface elevation n/a feet MSL

This Authorization Expires 3-19-86

Approved By 9-19-85 *R. Galloway*

I certify that we will comply with K.S.A. 55-101, et seq., plus eventually plugging holes to K.C.C. specifications.

Date 9/17/85 Signature of Operator or Agent *J. H. Galloway*

Title President

If production casing is run it will be cemented through usable water zone immediately


Must be filed with the K.C.C. five (5) days prior to commencing well
This card void if drilling not started within six (6) months of date received by K.C.C.

RECEIVED
STATE CORPORATION COMMISSION

SEP 19 1985

Important procedures to follow: CONSERVATION DIVISION
Wichita, Kansas

A Regular Section of Land
1 Mile = 5,280 Ft.

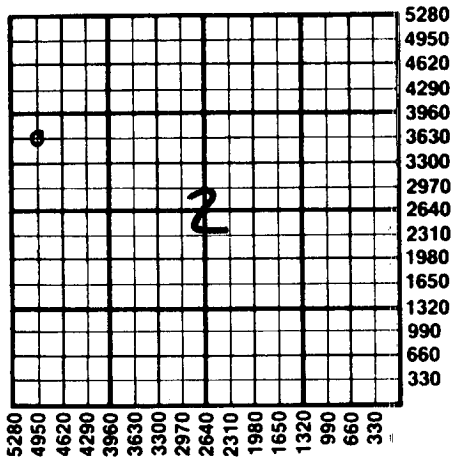

1. Notify District office before setting surface casing.
2. Set surface casing by circulating cement to the top.
3. File completion forms ACO-1 with K.C.C. within 90 days of well completion, following instructions on ACO-1, side 1, and including copies of wireline logs.
4. Notify District office 48 hours prior to old well workover or re-entry.
5. Prior to plugging, prepare a plugging plan, then obtain agreement from the appropriate district office for an approved plugging plan.
6. Submit plugging report (CP-4) to K.C.C. after plugging is completed.
7. Obtain an approved injection docket number before disposing of salt water.
8. Notify K.C.C. within 10 days when injection commences or terminates.
9. If an alternate 2 completion, cement in the production pipe from below any usable water to surface within 120 days of spud date.

State Corporation Commission of Kansas
Conservation Division
200 Colorado Derby Building
Wichita, Kansas 67202
(316) 263-3238