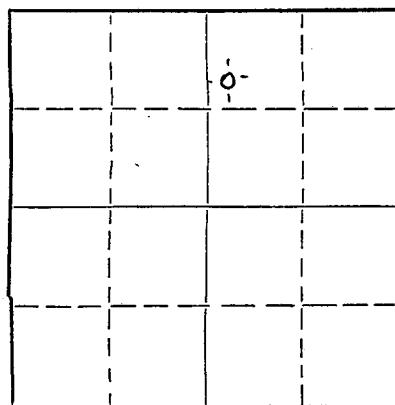


STATE OF KANSAS
STATE CORPORATION COMMISSION

Give All Information Completely
Make Required Affidavit
Mail or Deliver Report to:
Conservation Division
State Corporation Commission
800 Bitting Building
Wichita, Kansas

NORTH

Locate well correctly on above
Section Plat

WELL PLUGGING RECORD

15-163-02579-0000

Block County. Sec. 13 Twp. 10S. Rge. 19W. (E) (W)
Location as "NE/CNW 1/4 SW 1/4" or footage from lines SW NW NE
Lease Owner Strain Drilling Co.
Lease Name Baumstimler Well No. #1
Office Address Box 188, Hays, Kansas.
Character of Well (completed as Oil, Gas or Dry Hole) Dry Hole
Date well completed 1-14 19 52
Application for plugging filed 1-14 19 52
Application for plugging approved 1-14 19 52
Plugging commenced 1-14 4:00 P.M. 19 52
Plugging completed 1-14 1200 P.M. 19 52
Reason for abandonment of well or producing formation Dry Hole

If a producing well is abandoned, date of last production 19
Was permission obtained from the Conservation Division or its agents before plugging was commenced? Yes Verbal

Name of Conservation Agent who supervised plugging of this well

Producing formation Depth to top Bottom Total Depth of Well 3695 Feet

Show depth and thickness of all water, oil and gas formations.

OIL, GAS OR WATER RECORDS

CASING RECORD

Formation	Content	From	To	Size	Put In	Pulled Out
Soil & shale		0	180	8 5/8"	180 ft	none
Kansas City		334.9	358.6		dry	dry
Arbuckle		367.7	369.5		dry	dry
Total Depth						

Describe in detail the manner in which the well was plugged, indicating where the mud fluid was placed and the method or methods used in introducing it into the hole. If cement or other plugs were used, state the character of same and depth placed, from feet to feet for each plug set.

Stirred pits well, filled hole with heavy mud. Placed wood plug at 155 Ft. Ran 1/2 sk hulls and 15 sks cement on same. Filled hole with heavy mud to 40 Ft. Placed wood plug at 40'. Ran 1/2 Sack hulls and 10 sacks of cement filling to bottom of cellar.

Strain

(If additional description is necessary, use BACK of this sheet)

Name of Plugging Contractor Strain Drilling Company C JAN 18 1952
Address Box 188, Hays, Kansas.

STATE OF Kansas, COUNTY OF Ellis, ss.

T.C. Strain (employee of owner) or (owner or operator) of the above-described well, being first duly sworn on oath, says: That I have knowledge of the facts, statements, and matters herein contained and the log of the above-described well as filed and that the same are true and correct. So help me God.


(Signature) T.C. Strain

Box 188, Hays, Kansas.
(Address)

SUBSCRIBED AND SWORN TO before me this 18 day of January, 19 52

commission expires July 18, 1955

23-8390-s 6-51-20M

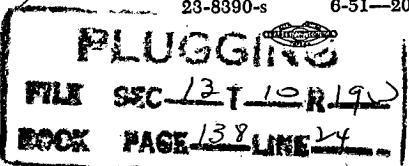

Notary Public.

WELL LOG

COMPANY: Strain Drilling Company et al

LEASE: Baumstimler #1

SW-NW-NE, Sec. 13,
Twp. 10s, Rge. 19W
Rooks County, Kansas.

ELEVATION: 2144 Derrick Floor

NOTE: All Meas. rotary bushings.

0	180 Soil, Shale
180	600 Shale
600	1035 Shale
1035	1210 Sand
1210	1250 Sand
1250	1435 Red Bed & Shale
1435	1535 Red Bed
1535	1550 Anhydrite
1550	1575 Anhydrite
1575	1840 Shale & Shells
1840	2080 Shale & Snells
2080	2225 Shale & Lime
2225	2370 Shale & Lime
2370	2445 Shale & Lime
2445	2535 Shale & Lime
2535	2650 Lime & Shale
2650	2740 Lime & Shale
2740	2840 Lime & Shale
2840	2965 Shale & Lime
2965	3095 Shale & Lime
3095	3145 Lime
3145	3190 Lime
3190	3250 Lime
3250	3284 Lime
3284	3321 Lime
3321	3360 Lime
3360	3400 Lime
3400	3455 Lime
3455	3494 Lime
3494	3525 Lime
3525	3580 Lime
3580	3632 Conglomerate
3632	3670 Chirt To Cong.
3670	3677 Chirt to Cong.
3677	3695 Arbuckle Lime
3695 T.D.	(R.B. Meas.)

COMMENCED: 1-4-52
COMPLETED: 1-14-52CASING RECORD:8 5/8" Surface casing set at 180'
w/125 sks cement by Globe Cementing
Company.D.S.T. BY Johnston Testing Company3525-3520' Tool Open 30 minutes
Recovered 36 Ft. Rotary Mud. B.H.P.
15 Min.

No Electric Log Run.

TOPS:

Anhydrite	1535	Conglomerat	3586 (-1440)
Topeka	3096 (-950)	Arbuckle	3677 (-1531)
Heebner	3308 (-1162)	Total Depth	3695 (-1549)
Lansing K. C.	3349 (-1203)		

STATE OF KANSAS)SS.
COUNTY OF ELLIS)I hereby affirm that the above and foregoing is a true
and correct copy of the log of the Baumstimler #1, located SW-NW-NE,
Sec. 13, Twp. 10s, Rge. 19W, Rooks County, Kansas.CONTRACTOR STRAIN DRILLING COMPANYBy F. Strain

F. Strain

Subscribed and sworn to before me this 18th day of January 1952.My Commission expires July, 1952.F. Strain
NOTARY PUBLIC

15-163-02579-0000
13-10-1952
13-10-52