


15-163-00560-0000

STATE OF KANSAS
STATE CORPORATION COMMISSION
Give All Information Completely
Make Required Affidavit
Mail or Deliver Report to:
Conservation Division
State Corporation Commission
800 Bitting Building
Wichita, Kansas

WELL PLUGGING RECORD

Rooks County. Sec. 15 Twp. 10S Rge. 19W (E) (W)
Location as "NE/CNW/SW" or footage from lines NW/4 NW/4 NW/4
Lease Owner Walters Drilling Co., Inc.
Lease Name Burke Well No. 1
Office Address 510 Orpheum Building, Wichita, Kansas
Character of Well (completed as Oil, Gas or Dry Hole) Dry Hole
Date well completed September 30, 19 53
Application for plugging filed (verbal) September 30, 19 53
Application for plugging approved (verbal) September 30, 19 53
Plugging commenced September 30, 19 53
Plugging completed September 30, 19 53
Reason for abandonment of well or producing formation Dry Hole

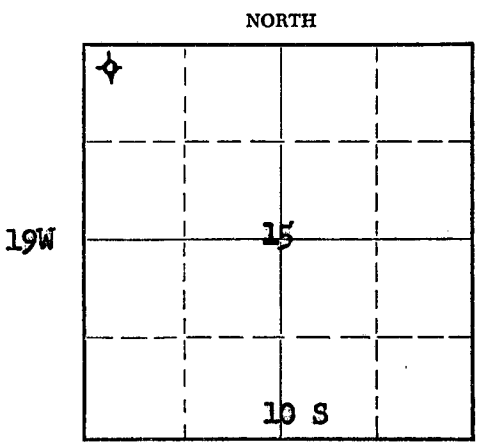

Locate well correctly on above Section Plat

If a producing well is abandoned, date of last production _____ 19____
Was permission obtained from the Conservation Division or its agents before plugging was commenced? Yes

Name of Conservation Agent who supervised plugging of this well Eldon Petty, Hays, Kansas
Producing formation _____ Depth to top _____ Bottom _____ Total Depth of Well 3810 Feet
Show depth and thickness of all water, oil and gas formations.

OIL, GAS OR WATER RECORDS

CASING RECORD

FORMATION	CONTENT	FROM	TO	SIZE	PUT IN	PULLED OUT
None	None	0	160'	8 5/8"	160'	None
	cemented with 100 sacks cement and 1 Gal. Chloride					
	(No oil string run - dry and abandoned)					

Describe in detail the manner in which the well was plugged, indicating where the mud fluid was placed and the method or methods used in introducing it into the hole. If cement or other plugs were used, state the character of same and depth placed, from _____ feet to _____ feet for each plug set.

Set bottom plug with heavy mud at 155' with 15 sacks cement


Set top plug at 40' with heavy mud with 10 sacks cement

Name of Plugging Contractor Walters Drilling Co., Inc. (If additional description is necessary, use BACK of this sheet)
Address 510 Orpheum Building, Wichita, Kansas

STATE OF KANSAS COUNTY OF SEDGWICK ss.
Robert F. Walters (employee of owner) or (~~owner or operator~~) of the above-described well, being first duly sworn on oath, says: That I have knowledge of the facts, statements, and matters herein contained and the log of the above-described well as filed and that the same are true and correct. So help me God.

(Signature) Robert F. Walters
510 Orpheum Building, Wichita, Kansas
(Address)

SUBSCRIBED AND SWORN TO before me this 1st day of October, 19 53.

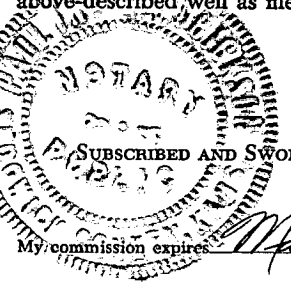

Pauline Redburn
Notary Public.

PLUGGING
FLX SEC 15 T 10 R 19W
BOOK PAGE 133 LINE 9

24-7368-5 3-53-20M
10-6-53

BURKE NO. 1

Location:	NW NW NW Sec. 15-10S-19W Rooks County, Kansas	Date Spudded: 9-19-53
Operator:	Walters Drilling Co., Inc.	Rotary Completion: 9-30-53
Contractor:	Walters Drilling Co., Inc.	Elevation: 2204 Gr 2207 DF 2209 KB
Surface Casing:	8 5/8" set at 160' with 100 sacks cement and 1 sack Cal. Chloride	
Oil String:	None. D & A	

L O G

(Figures indicate bottom of formation)

Surface	0 to 160
Sand and Shale	458
Shale and Shells	1041
Sand	1290
Shale and Shells	1569
Anhydrite	1611
Shale	1642
Shale and Shells	2479
Lime and Shale	2526
Lime	2603
Lime and Shale	3150
Shale	3198
Lime	3275
Lime and Shale	3330
Lime	3710
Lime and Shale	3788
Lime	3810
Total Depth (Rotary)	3810

The undersigned, Robert F. Walters, hereby certifies that the above log is a true and correct log of the formations encountered in drilling the above noted well as reflected by the Daily Drilling Reports.

WALTERS DRILLING CO., INC.

By Robert F. Walters

Subscribed and sworn to before me
this 1st day of October, 1953.

Pauline W. Anderson
Notary Public

My commission expires: March 10, 1956

