


15-163-02617-0000

STATE OF KANSAS  
STATE CORPORATION COMMISSION

Give All Information Completely  
Make Required Affidavit  
Mail or Deliver Report to:  
Conservation Division  
State Corporation Commission  
212 North Market, Insurance Bldg.  
Wichita, Kansas

WELL PLUGGING RECORD

NORTH

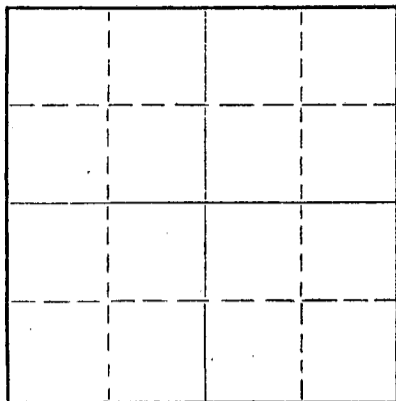

Locate well correctly on above  
Section Plat

Rooks County, Sec. 16 Twp. 10S Rge. 19 (E) 19 (W)  
Location as "NE/CNW&SWK" or footage from lines SW NW NE  
Lease Owner Sunray Mid-Continent Oil Company  
Lease Name R. E. Johnson Well No. 1  
Office Address Box 788, Great Bend, Kansas  
Character of Well (completed as Oil, Gas or Dry Hole) Dry Hole  
Date well completed 6-30 19 60  
Application for plugging filed 6-30 19 60  
Application for plugging approved 6-30 19 60  
Plugging commenced 6-30 19 60  
Plugging completed 6-30 19 60  
Reason for abandonment of well or producing formation

If a producing well is abandoned, date of last production 19  
Was permission obtained from the Conservation Division or its agents before plugging was commenced? Yes

Name of Conservation Agent who supervised plugging of this well Eldon Petty  
Producing formation Depth to top Bottom Total Depth of Well 3685 Feet  
Show depth and thickness of all water, oil and gas formations.

OIL, GAS OR WATER RECORDS

CASING RECORD

| FORMATION | CONTENT | FROM | TO | SIZE  | PUT IN                  | PULLED OUT |
|-----------|---------|------|----|-------|-------------------------|------------|
|           |         |      |    | 8-5/8 | 376<br>236<br>E1<br>KCC | None       |
|           |         |      |    |       |                         |            |
|           |         |      |    |       |                         |            |
Describe in detail the manner in which the well was plugged, indicating where the mud fluid was placed and the method or methods used in introducing it into the hole. If cement or other plugs were used, state the character of same and depth placed, from feet to feet for each plug set.

Set Wooden plug at 550'. Dumped 20 sax cement on top of plug.  
Set plug at 180'. Dumped 20 sax cement on top of plug.  
Set plug at 40'. 1/2 sax hulls and 10 sax cement on top of plug to surface.

RECEIVED  
STATE CORPORATION COMMISSION  
JUL 15 1960  
CONSERVATION DIVISION  
Wichita, Kansas

(If additional description is necessary, use BACK of this sheet)  
Name of Plugging Contractor Stickle Drilling Company  
Address Tulsa, Oklahoma

STATE OF Kansas, COUNTY OF Barton, ss.  
J. R. Nichols (employee of owner) of the above-described well, being first duly sworn on oath, says: That I have knowledge of the facts, statements, and matters herein contained and the log of the above-described well as filed and that the same are true and correct. So help me God.

(Signature) [Signature]  
P.O. Box 788, Great Bend, Kansas  
(Address)

SUBSCRIBED AND SWORN TO before me this 13th day of July, 19 60

My commission expires 12-24-60 Notary Public.



603h

Re

15-163-02617-0000

Sunray Mid-Continent Oil Company  
Tulsa, Oklahoma

Tulsa, Oklahoma  
July 11, 1960

Contractor: Stickle Drilling Company  
Date Commenced: June 22, 1960  
Date Completed: June 30, 1960

Rebt. E. Johnson No. 1  
SW NW NE Sec. 16-10S-19W  
Rooks County, Kansas

DRILLER'S LOG

Depth Figures Indicate Base of Formation:

|                              |         |
|------------------------------|---------|
| Clay and Sand                | 100     |
| Sandy Shale                  | 200     |
| Shale                        | 237     |
| Shale and shells             | 705     |
| Shale, Red Bed & Sd. Streaks | 920     |
| Shale                        | 980     |
| Sand                         | 1225    |
| Red Bed                      | 1551    |
| Anhydrite                    | 1590    |
| Shale & Red Bed              | 2016    |
| Shale & shells & lm. streaks | 2220    |
| Shale & Lime                 | 2415    |
| Shale & Lm. streaks          | 2460    |
| Shale and salt streaks       | 2490    |
| Shale & Lime                 | 2700    |
| Lime streaks & shale         | 2900    |
| Shale and Lime               | 3360    |
| Lime and shale               | 3440    |
| Lime                         | 3685 TD |

I, Fred E. Stickle, hereby certify the above to be a true and complete Driller's Log of Sunray Mid-Continent's Robert E. Johnson Well No. 1, SW/4 NE/4 NE/4 of Section 16-10S-19W., Rooks County, Kansas.

*Fred E. Stickle*  
Fred E. Stickle

*Edith A. Lawver*  
Notary Public

My commission expires March 24, 1964

RECEIVED  
CORPORATION COMMISSION  
JUL 15 1960  
CONSERVATION DIVISION  
Wichita, Kansas