


STATE OF KANSAS
STATE CORPORATION COMMISSION

Give All Information Completely
Make Required Affidavit
Mail or Deliver Report to:
Conservation Division
State Corporation Commission
211 No. Broadway
Wichita, Kansas

WELL PLUGGING RECORD

15-163-02618-0000

NORTH

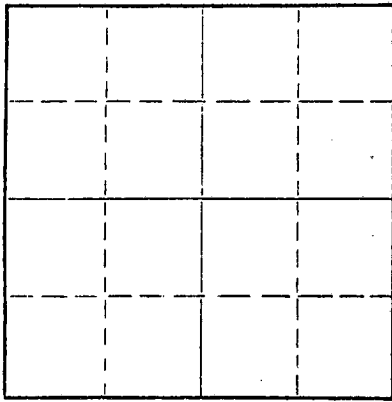

Locate well correctly on above
Section Plat

Rooks County. Sec. 16 Twp. 10S Rge. 19W (E) (W)
Location as "NE/CNW%SW%" or footage from lines NE ~~S~~ NW
Lease Owner Sunray Mid-Continent Oil Company
Lease Name Gladys Johnston Well No. 2
Office Address P. O. Box 729, Great Bend, Kansas
Character of Well (completed as Oil, Gas or Dry Hole) Dry Hole
Date well completed February 24, 1962
Application for plugging filed February 1962
Application for plugging approved February 24, 1962
Plugging commenced February 24, 1962
Plugging completed February 24, 1962
Reason for abandonment of well or producing formation

If a producing well is abandoned, date of last production 19
Was permission obtained from the Conservation Division or its agents before plugging was commenced? Yes - by telephone

Name of Conservation Agent who supervised plugging of this well Eldon Petty
Producing formation Depth to top Bottom Total Depth of Well 3760 Feet
Show depth and thickness of all water, oil and gas formations.

OIL, GAS OR WATER RECORDS

CASING RECORD

FORMATION	CONTENT	FROM	TO	SIZE	PUT IN	PULLED OUT
				8 5/8"	252'	None
				10.75		
				21 KCC		

Describe in detail the manner in which the well was plugged, indicating where the mud fluid was placed and the method or methods used in introducing it into the hole. If cement or other plugs were used, state the character of same and depth placed, from feet to feet for each plug set.

Cement plugs, consisting of Pozmix cement, were placed at:
Plug #1, 20 sacks, placed at 550'.
Plug #2, 20 sacks, placed at 180'.
Plug #3, 10 sacks, placed at 30'.

All intervals between cement plugs is filled with 10.3# mud laden fluid.

RECEIVED
STATE CORPORATION COMMISSION
3-23-62
MAR 23 1962
CONSERVATION DIVISION
Wichita, Kansas


(If additional description is necessary, use BACK of this sheet)

Name of Plugging Contractor Halliburton Company
Address Duncan, Oklahoma

STATE OF Kansas, COUNTY OF Barton, ss.
C. C. Shreve (employee of owner) or (owner or operator) of the above-described well, being first duly sworn on oath, says: That I have knowledge of the facts, statements, and matters herein contained and the log of the above-described well as filed and that the same are true and correct. So help me God.

(Signature) C. C. Shreve, District Manager
P. O. Box 729, Great Bend, Kansas (Address)

SUBSCRIBED AND SWORN to before me this 22nd. day of March, 1962

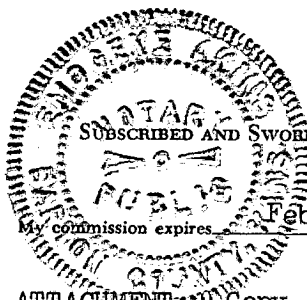

February 7, 1966

Eugene Atkins
Notary Public.

ATTACHMENT: Copy of Drilling Log

15-163-02618-000

Sunray Mid-Continent Oil Company
Tulsa, Oklahoma

Tulsa, Oklahoma
March 2, 1962

Contractor: Stickle Drilling Company
Commenced: February 14, 1962
Completed: February 25, 1962

Gladys Johnston No. 2
NE SW NW Section 16-10S-19W
Rooks County, Kansas

DRILLER'S LOG

Depth Figures Indicate Base of Formation:

Sand and shale	1337
Shale	1549
Anhydrite	1599
Shale	1930
Shale and lime	2280
Lime and shale	2535
Lime w/shale streaks	2665
Lime	2955
Lime and shale	3180
Lime	3193
Lime and shale	3265
Lime	3662
Conglomerate	3705
Lime and Dolomite	3730
Arbuckle	3760 TD

I, Fred E. Stickle, hereby certify the above to be a true and complete Driller's Log of Sunray Mid-Continent Oil Company's Gladys Johnston, Well No. 2, NE/4 of SW/4 of NW/4 of Section 16-10S-19W., Rooks County, Kansas.

Fred E. Stickle
FRED E. STICKLE

Edith A. Lauerer
Notary Public

My Commission expires March 24, 1964.

RECEIVED
COMMISSION
MAR 2 1962
CONSERVATION DIVISION
Wichita, Kansas

Notary Public Seal