


STATE OF KANSAS
STATE CORPORATION COMMISSION

15-051-00231-00-00
WELL PLUGGING RECORD

Give All Information Completely
Make Required Affidavit
Mail or Deliver Report to:
Conservation Division
State Corporation Commission
800 Bitting Building
Wichita, Kansas

Ellis County, Sec. 10 Twp. 12 Rge. (E) 16 (W)

Location as "NE/CNW/SW" or footage from lines C. E/2 NE SE
Lease Owner Graham-Messman-Rinehart Oil Company
Lease Name Dickinson Well No. 1
Office Address 1005 E. Second Street
Character of Well (completed as Oil, Gas or Dry Hole) Dry Hole
Date well completed April 7, 19 53
Application for plugging filed April 6, 19 53
Application for plugging approved April 6, 19 53
Plugging commenced April 7, 19 53
Plugging completed April 7, 19 53
Reason for abandonment of well or producing formation Dry

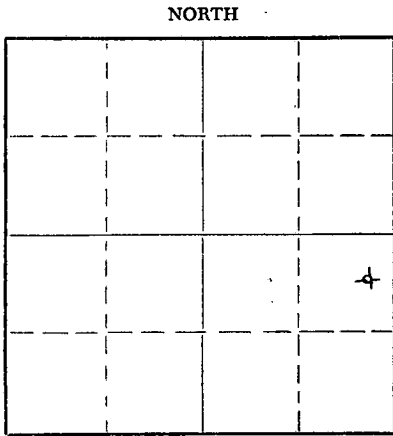

Locate well correctly on above
Section Plat

If a producing well is abandoned, date of last production _____ 19____
Was permission obtained from the Conservation Division or its agents before plugging was commenced? yes

Name of Conservation Agent who supervised plugging of this well Mr. Eldon Petty, Box 326, Hays, Kansas
Producing formation _____ Depth to top _____ Bottom _____ Total Depth of Well 3390 Feet
Show depth and thickness of all water, oil and gas formations.

OIL, GAS OR WATER RECORDS

CASING RECORD

| FORMATION | CONTENT | FROM | TO | SIZE | PUT IN | PULLED OUT |
|-----------|---------|------|----|-------|--------|------------|
| | | | | 8 5/8 | @ 150 | none |
| | | | | 5 1/2 | 3385 | 2650 |
| | | | | | | |
| | | | | | | |
| | | | | | | |
| | | | | | | |

Describe in detail the manner in which the well was plugged, indicating where the mud fluid was placed and the method or methods used in introducing it into the hole. If cement or other plugs were used, state the character of same and depth placed, from _____ feet to _____ feet for each plug set.

Filled up with sand to 2758'. Dump
5 sx. cement. Filled up with mud
to 150'. Plug rock bridge w/15 sx.
cement. Mud to 30'. Plug rock bridge
at 30' w/10 sx. cement. Mud to surface.

STATE CORPORATION COMMISSION
4-10-1953
APR 16 1953
CONSERVATION DIVISION
Wichita, Kansas


(If additional description is necessary, use BACK of this sheet)
Name of Plugging Contractor Graham-Messman-Rinehart Oil Company
Address 1005 E. Second St., Wichita, Kansas

STATE OF Kansas, COUNTY OF Sedgwick, ss.
J. A. Gilliland (employee of owner) or (owner of operation) of the above-described well, being first duly sworn on oath, says: That I have knowledge of the facts, statements, and matters herein contained and the log of the above-described well as filed and that the same are true and correct. So help me God.

(Signature) J. A. Gilliland
1005 E. Second St., Wichita, Kansas
(Address)

SUBSCRIBED AND SWORN to before me this 15th day of April, 19 53
My commission expires December 1, 1956
Barbara J. Scott Notary Public.

PLUGGING
FILE SEC 10 T 12 R 16 W
BOOK PAGE 90 LINE 16

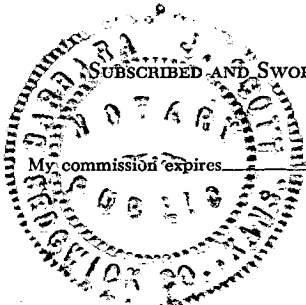

DICKINSON #1

WELL RECORD

Location: C. E/2 NE SE Sec. 10-12-16W
Ellis County, Kansas

Commenced: February 22, 1953

Operator: G-M-R Oil Company

Completed: March 4, 1953

Contractor: G-M-R Oil Company

Production: D & A

Casing Record: 8 5/8" @ 150' w/90 sx.
5 1/2" @ 3385 w/100 sx.

Elevation: 1833 K.B.

LOG

| | |
|--------------------|-----------|
| Shale & shells | 150 |
| Shale & shells | 325 |
| Sand | 635 |
| Shale & redbed | 940 |
| Shale & redbed | 973 |
| Anhydrite | 1016 |
| Shale | 1311 |
| Lime & shale | 1714 |
| Brown lime | 1925 |
| Shale & brown lime | 1997 |
| Lime & shale | 2135 |
| Lime & shale | 2300 |
| Lime & shale | 2417 |
| Lime & shale | 2544 |
| Lime & shale | 2690 |
| Lime & shale | 2690 |
| Lime & shale | 2790 |
| Lime | 2850 |
| Lime | 2924 |
| Lime & shale | 2972 |
| Lime & shale | 3007 |
| Lime & shale | 3068 |
| Lime | 3090 |
| Lime | 3110 |
| Lime | 3168 |
| Lime | 3211 |
| Lime | 3260 |
| Lime | 3316 |
| Conglomerate | 3331 |
| Lime | 3353 |
| Lime | 3390 T.D. |

TOPS

| | |
|------|----------------------|
| 3030 | Lansing (-1197) |
| 3315 | Conglomerate (-1485) |
| 3331 | Simpson (-1501) |
| 3382 | Arbuckle (-1549) |

The undersigned, GRAHAM-MESSMAN-RINEHART OIL COMPANY, hereby certifies that the above log is a true and correct log of the formations encountered in drilling the above well as reflected by the Daily Drilling Reports.

GRAHAM-MESSMAN-RINEHART OIL COMPANY

BY J. A. Gilliland
J. A. Gilliland

Subscribed and sworn to before me this 6th day of April, 1953.

Barbara J. Scott
Notary Public

My commission expires: December 1, 1956

APR 7 1953

RESERVATION
Wichita, Kansas

PLUGGING
FILE SEC 10 T 12 R 16W
BOOK PAGE 90 LINE 16