


Give All Information Completely  
Make Required Affidavit  
Mail or Deliver Report to:  
Conservation Division  
State Corporation Commission

WELL PLUGGING RECORD

P. O. Box 17027  
Wichita, Kansas 67217  
NORTH

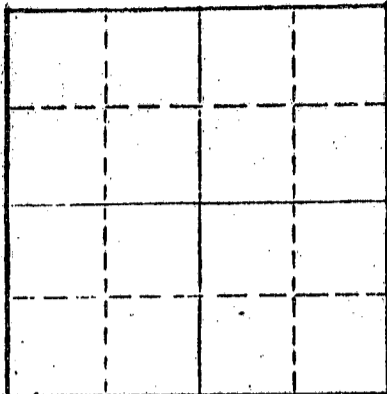

Locate well correctly on above Section Plot

Ellis County, Sec. 12 Twp. 12 Rge. 16 (X) W (W)  
Location as "NE/CNWKSWK" or footage from lines SW SW SW  
Lease Owner Dreiling Oil Inc.  
Lease Name Dreiling 'C' Well No. 5  
Office Address R.R. 2 Victoria, Kansas 67671  
Character of Well (completed as Oil, Gas or Dry Hole) Oil Well  
Date well completed June 19 61  
Application for plugging filed May 20 19 74  
Application for plugging approved May 22 19 74  
Plugging commenced July 25 19 74  
Plugging completed July 25 19 74  
Reason for abandonment of well or producing formation Depleted

If a producing well is abandoned, date of last production January 19 65  
Was permission obtained from the Conservation Division or its agents before plugging was commenced? Yes

Name of Conservation Agent who supervised plugging of this well Leo Massey Hays, Kansas  
Producing formation \_\_\_\_\_ Depth to top \_\_\_\_\_ Bottom \_\_\_\_\_ Total Depth of Well 3,347 Feet  
Show depth and thickness of all water, oil and gas formations.

OIL, GAS OR WATER RECORDS

CASING RECORD

FORMATION	CONTENT	FROM	TO	SIZE	PUT IN	PULLED OUT
Surface	Casing	0	121'	8 5/8"	121'	0
Kansas City	Casing	0	3,342'	5 1/2"	3,342'	0

Describe in detail the manner in which the well was plugged, indicating where the mud fluid was placed and the method or methods used in introducing it into the hole. If cement or other plugs were used, state the character of same and depth placed, from \_\_\_\_\_ feet to \_\_\_\_\_ feet for each plug set.

1st plug set at 3,300' with 2 sacks cement  
2nd plug set at 2,900' with 50' sand and 3 sacks cement  
3rd plug set at 500' with 50' sand and 3 sacks cement

RECEIVED  
STATE CORPORATION COMMISSION  
8-13-1974  
AUG 13 1974  
CONSERVATION DIVISION  
Wichita, Kansas

(If additional description is necessary, use BACK of this sheet)

Name of Plugging Contractor Dreiling Oil Inc.  
Address R.R. 2 Victoria, Kansas 67671 License # 730

STATE OF Kansas COUNTY OF Ellis, ss.  
I, Joe Hess, Secretary-Treasurer (endorsement of name and position of officer) of the above-described well, being first duly sworn on oath, says: That I have knowledge of the facts, statements, and matters herein contained and the log of the above-described well as filed and that the same are true and correct. So help me God.

NOTARY PUBLIC KANSAS  
ELLIS COUNTY  
DIANA PRESLEY

(Signature) \_\_\_\_\_

(Address) \_\_\_\_\_

MY COMM. EXP. JUNE 24, 1978  
Subscribed and Sworn to before me this 12 day of August, 19 74

Diana Presley  
Notary Public.

My commission expires 6-29-78

**WELL LOG**

Company	<b>Leo J. Dreiling Oil Company</b> Victoria, Kansas	Sec. 12	Twp. 12	Rng. 16
Farm	Dreiling "C" No. # 5	Location	S1/2 S1/2 SW	
Total Depth	3342'	County	Ellis County, Kansas	
Comm.	5 - 28 - 61	Comp.	6 - 10 - 61	Elevation: D. F. 1850'
Contractor	<b>L. J. Dreiling &amp; Sons, Inc.</b> Victoria, Kansas			G. R. 1848'
	Casing Record 121' - - - 8 5/8	Cement Record 85 Bags Cement	Production:	Arbuckle

Figures Indicate Bottom of Formations

0 - 115	Shale & Shells
115 - 320	Blue Shale
320 - 375	Sand & Shale
375 - 650	Sand
650 - 765	Red Rock
765 - 993	Red Rock & Shale
993 - 1028	Anhydrite
1028 - 1035	Shale & Shells
1035 - 1620	Shale
1620 - 1815	Shale & Lime Shells
1815 - 1955	Lime
	TD

RECEIVED  
 STATE CORPORATION COMMISSION  
 5-22-1974  
 MAY 22 1974  
 CONSERVATION DIVISION  
 Wichita, Kansas

STATE OF KANSAS )  
 ) ss.  
 COUNTY OF ELLIS )

I, Leo F. Dreiling, of the L. J. Dreiling & Sons, Inc. upon oath states that the above and foregoing is a true and correct copy of the log from the Daily Drilling Report on your Dreiling "C" # 5.

Leo F. Dreiling  
 LEO F. DREILING

Subscribed and sworn to before me this 15th day of June, 1961.

J. M. Schumel  
 NOTARY PUBLIC

My Commission Expires: 7-20-61