


Give All Information Completely
Make Required Affidavit

Mail or Deliver Report to:
Conservation Division
State Corporation Commission
212 North Market, Insurance Bldg.
Wichita, Kansas

15-051-04358-00-00
WELL PLUGGING RECORD

NORTH

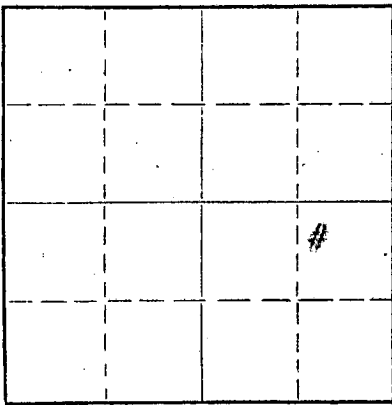

Locate well correctly on above
Section Plat

Ellis County. Sec. 15 Twp. 12 Rge. 16 (E) X (W)
Location as "NE/CNW/SW" or footage from lines SE/2 NE SE
Lease Owner Leo J. Drilling Oil Co.
Lease Name Dickinson Well No C-1
Office Address Victoria, Ks.
Character of Well (completed as Oil, Gas or Dry Hole) Dry hole
Date well completed _____ 19____
Application for plugging filed _____ 19____
Application for plugging approved _____ 19____
Plugging commenced March 4, 19 61
Plugging completed March 8, 19 61
Reason for abandonment of well or producing formation _____

If a producing well is abandoned, date of last production _____ 19____
Was permission obtained from the Conservation Division or its agents before plugging was commenced? Yes

Name of Conservation Agent who supervised plugging of this well Eldon Petty
Producing formation _____ Depth to top _____ Bottom _____ Total Depth of Well _____ Feet
Show depth and thickness of all water, oil and gas formations.


OIL, GAS OR WATER RECORDS

CASING RECORD

FORMATION	CONTENT	FROM	TO	SIZE	PUT IN	PULLED OUT
				8 5/8	125'	none
				5 1/2	3400'	3001'

Describe in detail the manner in which the well was plugged, indicating where the mud fluid was placed and the method or methods used in introducing it into the hole. If cement or other plugs were used, state the character of same and depth placed, from _____ feet to _____ feet for each plug set.

Plugged back with sand from 3409' to 3480'. Mixed and dumped 4 ex. cement from 3380' to 3348'. Pulled 5 1/2 casing to 300'. Circulated 11 ex. gel mud. Mixed and pumped in 20 ex. cement from 300' to 240'. Pulled 5 1/2 casing to 150'. Mixed and pumped in 20 ex. cement from 150' to 90'. Pulled rest pipe. Bailed off gel to 35'. Set 5' rock bridge from 35' to 30'. Mixed and dumped 10 ex. cement from 30' to base cellar.

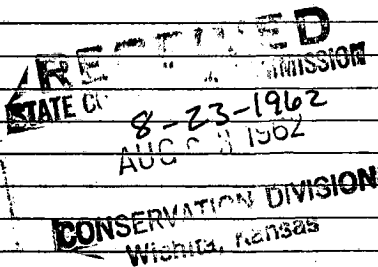

(If additional description is necessary, use BACK of this sheet)

Name of Plugging Contractor Ace Pipe Pulling Co.
Address Box 304, Great Bend, Ka.

STATE OF _____ COUNTY OF _____, ss.
_____, (employee of owner) or (owner or operator) of the above-described well, being first duly sworn on oath, says: That I have knowledge of the facts, statements, and matters herein contained and the log of the above-described well as filed and that the same are true and correct. So help me God.

(Signature) Leo J. Drilling

(Address)

SUBSCRIBED AND SWORN TO before me this _____ day of _____, 19____

My commission expires August 14, 1965

Ronald Zimmerman

Notary Public.



WELL LOG

Company	Leo J. Dreiling Oil Company Victoria, Kansas	Sec. 15	Twp. 12	Rng. 16 ^w
Farm	Dickinson No. C 1	Location	S2 NE SE	
Total Depth	3409'	County	Ellis County, Kansas	
Comm.	12-15-60	Comp.	12-22-60	Elevation: D. F. 1902
Contractor	L. J. Dreiling & Sons, Inc. Victoria, Kansas			G. R. 1900
	Casing Record 8 5/8 * * 125'	Cement Record 115 SACS CEMENT	Production:	ARBUCKLE

Figures Indicate Bottom of Formations

0 - 40	SURFACE CLAY
40 - 125	SHALE & SHELLS
125 - 320	SHALE & SHELLS
320 - 520	SAND & SHALE
520 - 565	HARD SAND
565 - 580	SHALE & SHELLS
580 - 690	SAND
690 - 960	RED ROCK SHALE
960 - 1058	SHALE
1058 - 1095	ANHYDRITE
1095 - 1105	SHALE
1105 - 1770	SHALE & SHELLS
1770 - 1945	SHALE & LIME
1945 - 2075	LIME
2075 - 2205	LIME & SHALE
2205 - 2365	LIME & SHALE
2365 - 2490	LIME & SHALE
2490 - 2715	SHALE
2715 - 2870	SHALE
2870 - 2925	LIME & SHALE
2925 - 3018	LIME
3018 - 3037	SHALE & LIME
3037 - 3070	LIME
3070 - 3155	LIME
3155 - 3225	LIME
3225 - 3265	LIME
3265 - 3310	LIME
3310 - 3378	LIME
3378 - 3409	LIME
3409	TD

RECEIVED
 STATE CORPORATION COMMISSION
 8-23-1962
 AUG 23 1962
 CONSERVATION DIVISION
 Wichita, Kansas

STATE OF KANSAS, COUNTY OF ELLIS, ss.

I, Leo J. Dreiling, of the L. J. Dreiling & Sons, Inc., upon oath states that the above and foregoing is a true and correct copy of the log from the Daily Drilling Report on your Dickinson C 1.

Leo J. Dreiling
 LEO J. DREILING

Subscribed and sworn to before me this 22th day of May, 1961.

Leon Zimmerman
 NOTARY PUBLIC

My Commission Expires: August 14, 1965

