


STATE OF KANSAS
STATE CORPORATION COMMISSION

Give All Information Completely
M&C Required Affidavit
Mail or Deliver Report to:
Conservation Division
State Corporation Commission
800 Bitting Building
Wichita, Kansas

OR
FORMATION PLUGGING RECORD

Strike out upper line
when reporting plugging
off formations.

Ellis County. Sec. 15 Twp. 12 Rge. 16 (E) (W)
Location as "NE 1/4 NW 1/4 SW 1/4" or footage from lines. SE NE of SE
Lease Owner V. D. Sidey
Lease Name Dickinson Well No. 1
Office Address Bldg. & Loan Bldg. Russell, Kansas
Character of Well (completed as Oil, Gas or Dry Hole) Dry
Date well completed 10-22-50 19
Application for plugging filed 10-22-50 19
Application for plugging approved 10-22-50 19
Plugging commenced 10-22-50 19
Plugging completed 10-22-50 19
Reason for abandonment of well or producing formation

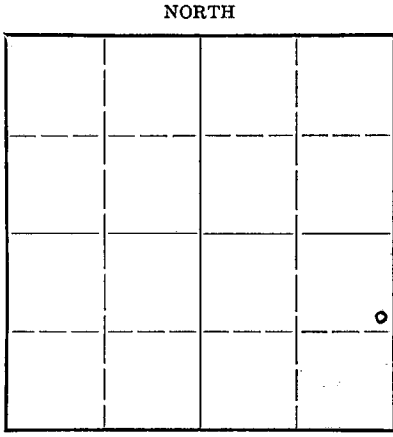

Locate well correctly on above
Section Plat

If a producing well is abandoned, date of last production 19
Was permission obtained from the Conservation Division or its agents before plugging was commenced? Yes

Name of Conservation Agent who supervised plugging of this well Petty
Producing formation Depth to top Bottom Total Depth of Well 2770 Feet
Show depth and thickness of all water, oil and gas formations.

OIL, GAS OR WATER RECORDS

CASING RECORD

Formation	Content	From	To	Size	Put In	Pulled Out
	Well was just cleaned out not drilled					

Describe in detail the manner in which the well was plugged, indicating where the mud fluid was placed and the method or methods used in introducing it into the hold. If cement or other plugs were used, state the character of same and depth placed, from feet to feet for each plug set.

Filled hole to 100'. Set plug & spotted 15 sacks cement.

Filled hole to 25' with mud. Set plug & 10 sacks cement.

No well log - well just cleaned out

RECEIVED
STATE CORPORATION COMMISSION
10-31-1950
OCT 31 1950

CONSERVATION DIVISION
Wichita, Kansas

(If additional description is necessary, use BACK of this sheet)

Correspondence regarding this well should be addressed to V. D. Sidey Oil Co.
Address Russell, Ks.

STATE OF Kansas, COUNTY OF Russell, ss.
V. D. Sidey (employee of owner) or (owner or operator) of the above-described well,
being first duly sworn on oath, says: That I have knowledge of the facts, statements, and matters herein contained and the log of the above-described well as filed and that the same are true and correct. So help me God.

(Signature) *V. D. Sidey*

P. O. Box 387 Russell, Kansas (Address)

SUBSCRIBED AND SWORN to before me this 22 day of October, 1950

My commission expires April 19, 1951

Margaretta Cummings
Notary Public.

PLUGGING
FILE SEC 15 T 12 R 16 W
BOOK PAGE 39 LINE 2

