


STATE OF KANSAS
STATE CORPORATION COMMISSION

15-051-00976-00-00
WELL PLUGGING RECORD

Give All Information Completely
Make Required Affidavit
Mail or Deliver Report to:
Conservation Division
State Corporation Commission
800 Bittling Building
Wichita, Kansas

Ellis County. Sec. 15 Twp. 12S Rge. 16 (EX) (W)

NORTH

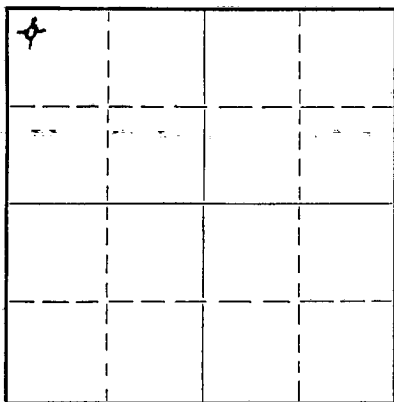

Locate well correctly on above
Section Plat

Location as "NE/CNW $\frac{1}{4}$ SW $\frac{1}{4}$ " or footage from lines NW NW NW
Lease Owner M. B. Armer & Pickrell Drilling Company, Inc.
Lease Name Froelich Well No. 1
Office Address 705 4th National Bank Bldg., Wichita 2, Kansas
Character of Well (completed as Oil, Gas or Dry Hole) D & A
Date well completed 3/18 19 50
Application for plugging filed 3/18 19 50
Application for plugging approved 3/18 19 50
Plugging commenced 3/18 19 50
Plugging completed 3/18 19 50
Reason for abandonment of well or producing formation D & A

If a producing well is abandoned, date of last production 19
Was permission obtained from the Conservation Division or its agents before plugging was commenced? Yes

Name of Conservation Agent who supervised plugging of this well Eldon Petty
Producing formation Depth to top Bottom Total Depth of Well 3440 Feet
Show depth and thickness of all water, oil and gas formations.

OIL, GAS OR WATER RECORDS

CASING RECORD

Formation	Content	From	To	Size	Put In	Pulled Out
				8 5/8"	152'	None
No Oil String of casing run.						

Describe in detail the manner in which the well was plugged, indicating where the mud fluid was placed and the method or methods used in introducing it into the hole. If cement or other plugs were used, state the character of same and depth placed, from feet to feet for each plug set.

Hole mudded with heavy mud to 150', set bridge and cemented with 15 sacks, heavy mud to 30', set bridge and cemented with 10 sacks to bottom of cellar.

3-27-1950
MAR 27 1950

(If additional description is necessary, use BACK of this sheet)

Correspondence regarding this well should be addressed to Pickrell Drilling Company, Inc.
Address 705 Fourth National Bank Bldg., Wichita 2, Kansas

STATE OF KANSAS, COUNTY OF SEDGWICK, ss.
Carl W. Sebitts (employee of owner) of the above-described well,

being first duly sworn on oath, says: That I have knowledge of the facts, statements, and matters herein contained and the log of the above-described well as filed and that the same are true and correct. So help me God.

(Signature) *Carl W. Sebitts*

705 4th National Bank Bldg., Wichita 2, Kansas
(Address)

SUBSCRIBED AND SWORN to before me this 21st day of March, 19 50

Ethel Zimmerman
Notary Public.

My commission expires January 28, 1953.

FILE SEC 16 T 12 R 16 W
BOOK PAGE 148 LINE 44

15-051-00976-00-00

COMPANY: ARMER DRILLING COMPANY, INC. Rotary Drilling Commenced: 3-9-50
 PICKRELL DRILLING COMPANY, INC. Rotary Drilling Completed: 3-18-50

LOCATION: CHRISTINA FROELICH #1
 NW NW NW Sec.15-128-16W
 Ellis County, Kansas

CONTRACTOR: PICKRELL DRILLING COMPANY, INC.
 Wichita, Kansas

CASING RECORD: 152' (5 jts.) 8 5/8" NEW 24# Smls. surface casing set at 152' in
 a 12 1/4" hole, cemented with 100 sacks cement.

Drilled 7 7/8" hole from 152' to 3440' TD. No Oil String run.

L O G

(Figures indicate bottom formation - measurements from top rotary bushing.)

Cellar	5	Circulate for samples at 3385'.
Shale & Shells	152	
Shells & Shale	390	Slope test at 1500' - 0° off.
Sand	650	" " " 2000' - 0° off.
Shale & Shells	1020	" " " 2500' - 0° off.
Anhydrite	1060	" " " 3000' - 0° off.
Red Bed	1435	SLM at 3440' O.K.
Shale & Red Bed	1630	
Lime	2075	Hole mudded with heavy mud to 150',
Lime & Shale	2415	set bridge and cemented with 15 sax,
Broken Lime	2685	heavy mud to 30', set bridge and
Lime & Shale	2868	cemented with 10 sacks to bottom of
Lime	3440 Rotary TD	cellar.

The undersigned, C. W. Sebitts, Secretary of PICKRELL DRILLING COMPANY, INC., hereby certifies in behalf of said corporation, that the above log is a true and correct log of the formation encountered in drilling the above well as reflected by the Daily Drilling Reports.


PICKRELL DRILLING COMPANY, INC.

By C. W. Sebitts
 Secretary

STATE OF KANSAS)
) SS
 COUNTY OF SEDGWICK)

BE IT REMEMBERED that on this 21st day of March, 1950, before me, the undersigned, a Notary Public, duly commissioned, in and for the county and state aforesaid, came C. W. Sebitts, Secretary of PICKRELL DRILLING COMPANY, INC., a corporation of the State of Kansas, personally known to me to be such officer, and to be the same person who executed as such officer the foregoing instrument of writing in behalf of said corporation, and he duly acknowledged the execution of the same for himself and for said corporation.

IN WITNESS WHEREOF, I have hereunto set my hand and official seal on the day and year last above written.

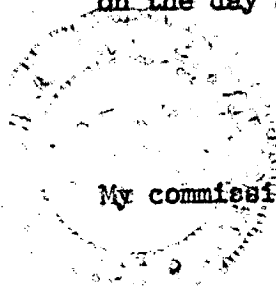

C. W. Sebitts
 Notary Public

My commission expires January 28, 1953.

3-27-1950

15-128-16W
 143