


OR

FORMATION PLUGGING RECORD

Strike out upper line  
when reporting plug-  
ging off formations.

Give All Information Completely  
Make Required Affidavit  
Mail or Deliver Report to:  
Conservation Division  
State Corporation Commission  
800 Bitting Building  
Wichita, Kansas

NORTH

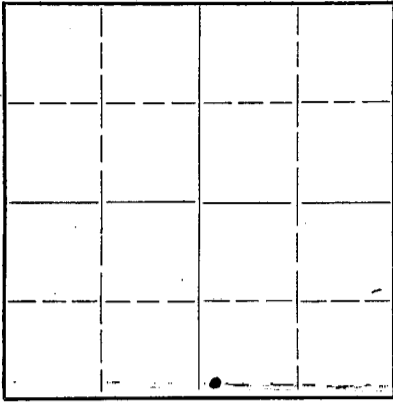

Locate well correctly on above  
Section Plat

Ellis County, Sec. 16 Twp. 12 Rge. 16 (E) W (W)  
Location as "NE1/4NW1/4SW1/4" or footage from lines SW1/4SW1/4SE1/4  
Lease Owner Nate Appleman Company  
Lease Name Jantzen Well No.  
Office Address 514 Bitting Bldg., Wichita, Kansas  
Character of Well (completed as Oil, Gas or Dry Hole) Dry hole  
Date well completed May 24 19 42  
Application for plugging filed May 26 19 42  
Application for plugging approved (Verbal) May 26 19 42  
Plugging commenced May 26 19 42  
Plugging completed May 26 19 42  
Reason for abandonment of well or producing formation Dry hole

If a producing well is abandoned, date of last production 19.  
Was permission obtained from the Conservation Division or its agents before plugging was com-  
menced? Yes

Name of Conservation Agent who supervised plugging of this well C. T. Alexander  
Producing formation Depth to top Bottom Total Depth of Well 3498 Feet  
Show depth and thickness of all water, oil and gas formations.

OIL, GAS OR WATER RECORDS


CASING RECORD

Formation	Content	From	To	Size	Put In	Pulled Out

Describe in detail the manner in which the well was plugged, indicating where the mud fluid was placed and the method or methods used in introducing it into the hold. If cement or other plugs were used, state the character of same and depth placed, from feet to feet for each plug set.  
Filled with mud to 265'  
Cement 230'  
Filled with 14# mud back to 30'  
Wooden plug set at 30'  
Filled to 5' of surface with cement and cap welded over top of surface pipe

pd.  
6/11/42  
H.A.

PLUGGING  
FILE 16 12 9 16W  
BOOK PAGE 36 LINE 15

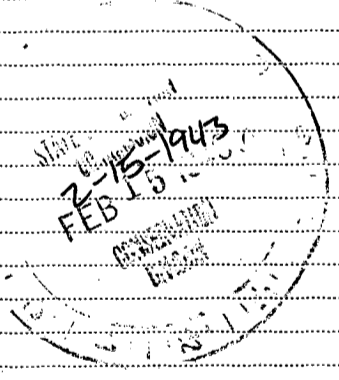

(If additional description is necessary, use BACK of this sheet)

Correspondence regarding this well should be addressed to B and R Drilling Company  
Address Box #487  
Russell, Kansas

STATE OF Kansas COUNTY OF Russell, ss.  
C.L. Roberts (employee of owner) or (owner or operator) of the above-described well,  
being first duly sworn on oath, says: That I have knowledge of the facts, statements, and matters herein contained and the log of the above-  
described well as filed and that the same are true and correct. So help me God.

(Signature) C.L. Roberts  
Box #487, Russell, Kansas (Address)  
19 42



SUBSCRIBED AND SWORN to before me this 28th day of May, 19 42.  
My commission expires July 2, 1945.  

B and R Drilling Company  
Jantzen #1

Sec. 16 Twp. 12 Rge. 11

Total Depth: 3498'  
Comm: 5/5/42 Comp: 5/24/42  
Issued: 5/27/42

County: Ellis, Kansas

Casing

10-3/4" 108' set 90 sack cement  
at 106'

Formation	Depth
Blue shale & shells	110'
Shale & shell	165'
Blue shale & shell	225'
Sand & shale	405'
Sand	460'
Sandy lime	470'
Sand	535'
Shale	600'
Sand	710'
Shale lime and iron	750'
Red bed	770'
Red bed	780'
Blue shale	792'
Shale, sand strks	980'
Shale, shells, sand	1050'
Red rock	1070'
Lime anhydrite	1110'
Shale and shells	1270'
Red bed, shale, shells	1405'
Shale, lime	1440'
Shale, shells	1640'
Salt, shells	1685'
Anhydrite and shale	1765'
Shells, shells, anhydrite	1805'
Lime broken	1865'
Lime and shale breaks	1945'
Lime, shale	2065'
Lime	2135'
Lime, shale	2255'
Lime	2480'
Red rock	2490'
Lime	2310'
Lime, shale	2690'
Shale, shells	2770'
Shale	2800'
Lime	2878'
Lime, shale, broken	2920'
Lime	3010'
Lime, shale breaks	3045'
Lime	3051'
Lime, soft white	3071'
Lime, gray hard	3095'
Shale, lime	3138'
Lime	3338'
Chert & lime	3340'
Lime	3401'
Lime, shale	3420'
Conglomerate	3427'
Conglomerate	3440'
Arbuckle lime	3461'
Lime and chert	3495'
Lime	3498'

5-29-1942

**PLUGGING**  
FILE # 16 12 46 W  
BOOK PAGE 36 LINE 15

I hereby certify that this is a true and exact copy of the log of this well, to the best of my knowledge.

Russell County, Kansas:

Subscribed and sworn to before me this 27th day of May, 1942

My commission expires: 4/23/1946

*Ed. R. Smith*  
*James H. Thomas*