

KANSAS CORPORATION COMMISSION
OIL & GAS CONSERVATION DIVISION
WELL PLUGGING APPLICATION
Please TYPE Form and File ONE Copy

Form CP-1
March 2009
This Form must be Typed
Form must be Signed
All blanks must be Filled

OPERATOR: License #: 32309
Name: Presco Western, LLC
Address 1: 5665 Flatiron Parkway
Address 2: _____
City: Boulder State: CO Zip: 80301 + _____
Contact Person: Susan Sears
Phone: (303) 444-8881

API No. 15 - 081-21772 - 0000
If pre 1967, supply original completion date: _____
Spot Description: _____
SE-SW. NW-NW Sec. 17 Twp. 30 S. R. 32 East West
1119 1149 Feet from North / South Line of Section
1,574 500 Feet from East / West Line of Section
Footages Calculated from Nearest Outside Section Corner:
 NE NW SE SW
County: Haskell
Lease Name: Eilerts Well #: 5-D17-30-32

KCC
PKP
per
ACO-1

Check One: Oil Well Gas Well OG D&A Cathodic Water Supply Well Other: _____
 SWD Permit #: _____ ENHR Permit #: _____ Gas Storage Permit #: _____

Conductor Casing Size: _____ Set at: _____ Cemented with: _____ Sacks
Surface Casing Size: 8-5/8" Set at: 1801 Cemented with: 750 Sacks
Production Casing Size: 5-1/2" Set at: 4954 Cemented with: 50 + 365 through port collar @ 3212 Sacks

List (ALL) Perforations and Bridge Plug Sets:

4700-4707 Swope

Elevation: 2912 (G.L. / K.B.) T.D.: 5850 PBDT: 4908 Anhydrite Depth: _____
(Stone Corral Formation)

Condition of Well: Good Poor Junk in Hole Casing Leak at: _____
(Interval)

Proposed Method of Plugging (attach a separate page if additional space is needed):

As per KCC rules

Is Well Log attached to this application? Yes No Is ACO-1 filed? Yes No

If ACO-1 not filed, explain why:

RECEIVED
SEP 28 2009
KCC WICHITA

Plugging of this Well will be done in accordance with K.S.A. 55-101 et. seq. and the Rules and Regulations of the State Corporation Commission

Company Representative authorized to supervise plugging operations: Kevin Newman 620-309-8413, Tony Aton 620-652-2403

Address: 303 S. Stubbs Road City: Ulysses State: KS Zip: 67880 + _____

Phone: (620) 356-5401

Plugging Contractor License #: _____ Name: To be determined

Address 1: _____ Address 2: _____

City: _____ State: _____ Zip: _____ + _____

Phone: (_____) _____

Proposed Date of Plugging (if known): _____

Payment of the Plugging Fee (K.A.R. 82-3-118) will be guaranteed by Operator or Agent

Date: 9/15/2009 Authorized Operator / Agent: Susan Sears (Signature)


Mail to: KCC - Conservation Division, 130 S. Market - Room 2078, Wichita, Kansas 67202

Dust
PKP

ELLORA ENERGY

EILERTS 5-D17-30-32
15-081-21772

HASKELL COUNTY
TWP: 30 S
RGE: 32 W
SEC: 17

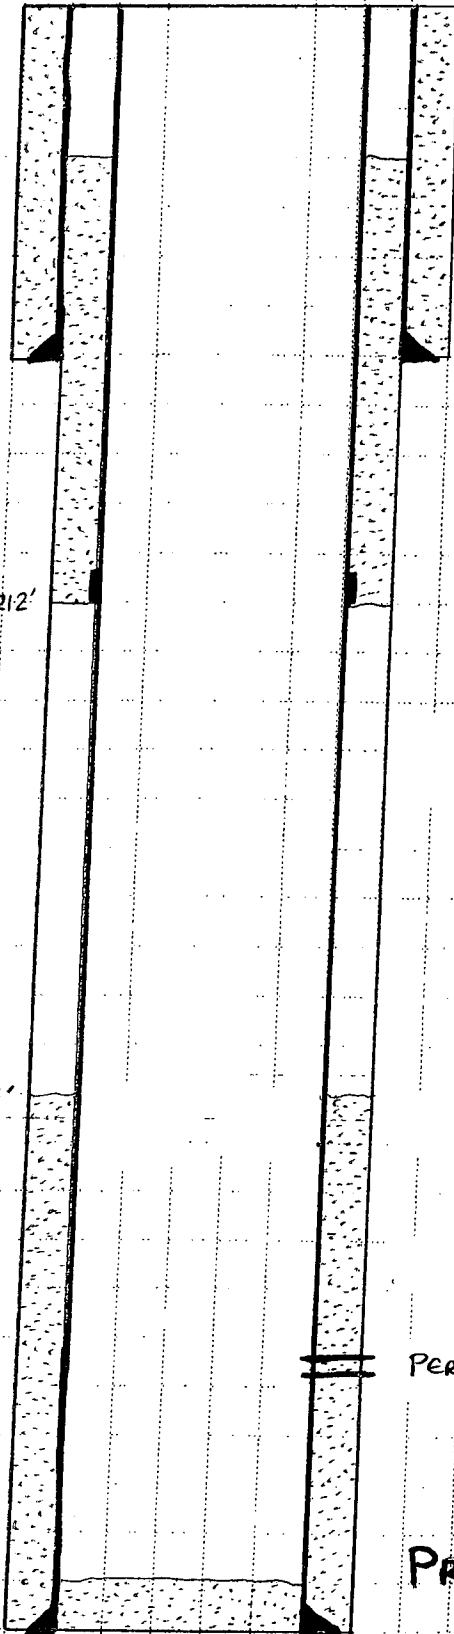

SURFACE CSG

8 7/8" 24# J-55 SET @ 1,801'
CMT'D W/ 750 SXS

PORT COLLAR @ 3,212'
CMT'D W/ 365 SXS

TOC @ 4,434'

PERFS 4,700' - 4,707' (SWOPE)

PBTD @ 4,908'

PRODUCTION CSG

5 1/2" 15.5 # SET @ 4,954'
CMT'D W/ 150 SXS

TD @ 5,350'

RECEIVED
SEP 28 2009
KCC WICHITA



CORPORATION COMMISSION

Mark Parkinson, Governor Thomas E. Wright, Chairman Michael C. Moffet, Commissioner Joseph F. Harkins, Commissioner

NOTICE OF RECEIPT OF WELL PLUGGING APPLICATION (CP-1)

PRESCO WESTERN LLC
5665 FLATIRON PKWY
BOULDER, CO 80301

October 05, 2009

Re: Eilerts #5-D17-30-32
API 15-081-21772-00-00
17-30S-32W, 1149 FNL 500 FWL
HASKELL COUNTY, KANSAS

Dear Operator:

This letter is to notify you that the Conservation Division has received your plugging proposal, form CP-1, for the above well and has reviewed the proposal for completeness. The central office will now forward your CP-1 to the district office listed below for review of the proposed plugging method. **Please contact the district office for approval of your proposed plugging method at least five (5) days before plugging the well, pursuant to K.A.R. 82-3-113(b). If a workover pit will be used during the plugging of the well it must be permitted. A CDP-1 form must be filed and approved prior to the use of the pit in accordance with K.A.R. 82-3-600.**

The Conservation Division's review of form CP-1, either in the central or district office, does not include an inquiry into well ownership or the filing operator's legal right to plug the well. This notice in no way constitutes authorization to plug the above well by persons not having legal rights of ownership or interest in the well.

This notice is void after April 3, 2010. The CP-1 filing does not bring the above well into compliance with K.A.R. 82-3-111 with regard to the Commission's temporary abandonment requirements.

Sincerely,

Steve Bond
Production Department Supervisor

District: #1
210 E Frontview, Suite A
Dodge City, KS 67801
(620) 225-8888