

KANSAS CORPORATION COMMISSION
OIL & GAS CONSERVATION DIVISION
WELL PLUGGING APPLICATION
Please TYPE Form and File ONE Copy

Form CP-1
March 2009
This Form must be Typed
Form must be Signed
All blanks must be Filled

OPERATOR: License #: 32309
Name: Presco Western, LLC
Address 1: 5665 Flatiron Parkway
Address 2: _____
City: Boulder State: CO Zip: 80301 + _____
Contact Person: Susan Sears
Phone: (303) 444-8881

API No. 15 - 081-21817 - 0000
If pre 1967, supply original completion date: _____
Spot Description: _____
SW-NE NE-NW Sec. 35 Twp. 30 S. R. 33 East West
335 Feet from North / South Line of Section
2,308 Feet from East / West Line of Section
Footages Calculated from Nearest Outside Section Corner:
 NE NW SE SW
County: Haskell
Lease Name: Andrews Trust Well #: 9-C35-30-33

Check One: Oil Well Gas Well OG D&A Cathodic Water Supply Well Other: _____
 SWD Permit #: _____ ENHR Permit #: _____ Gas Storage Permit #: _____

Conductor Casing Size: _____ Set at: _____ Cemented with: _____ Sacks
Surface Casing Size: 8-5/8" Set at: 1780 Cemented with: 750 Sacks
Production Casing Size: 5-1/2" Set at: 5650 Cemented with: 100 Sacks

List (ALL) Perforations and Bridge Plug Sets:

5343-5348 Morrow, 5374-5382 Morrow, 5389-5395 Morrow

Elevation: 2916 (G.L. / K.B.) T.D.: 5650 PBDT: 5565 Anhydrite Depth: _____
(Stone Corral Formation)

Condition of Well: Good Poor Junk in Hole Casing Leak at: _____
(Interval)

Proposed Method of Plugging (attach a separate page if additional space is needed):

As per KCC rules

Is Well Log attached to this application? Yes No Is ACO-1 filed? Yes No

If ACO-1 not filed, explain why:

Plugging of this Well will be done in accordance with K.S.A. 55-101 et. seq. and the Rules and Regulations of the State Corporation Commission

Company Representative authorized to supervise plugging operations: Kevin Newman 620-309-8413, Tony Aton 620-652-2403

Address: 303 S. Stubbs Road City: Ulysses State: KS Zip: 67880 + _____

Phone: (620) 356-5401

Plugging Contractor License #: _____ Name: To be determined

Address 1: _____ Address 2: _____

City: _____ State: _____ Zip: _____ + _____

Phone: (____) _____

Proposed Date of Plugging (if known): _____

Payment of the Plugging Fee (K.A.R. 82-3-118) will be guaranteed by Operator or Agent

Date: 9/15/2009 Authorized Operator / Agent: Susan Sears
(Signature)

Mail to: KCC - Conservation Division, 130 S. Market - Room 2078, Wichita, Kansas 67202

RECEIVED
SEP 28 2009
KCC WICHITA


Dust
PK

ELLORA ENERGY

ANDREWS TRUST 9-C35-30-33
15-081-21817

HASKELL COUNTY

TWP: 30 S
RGE: 33 W
SEC: 35

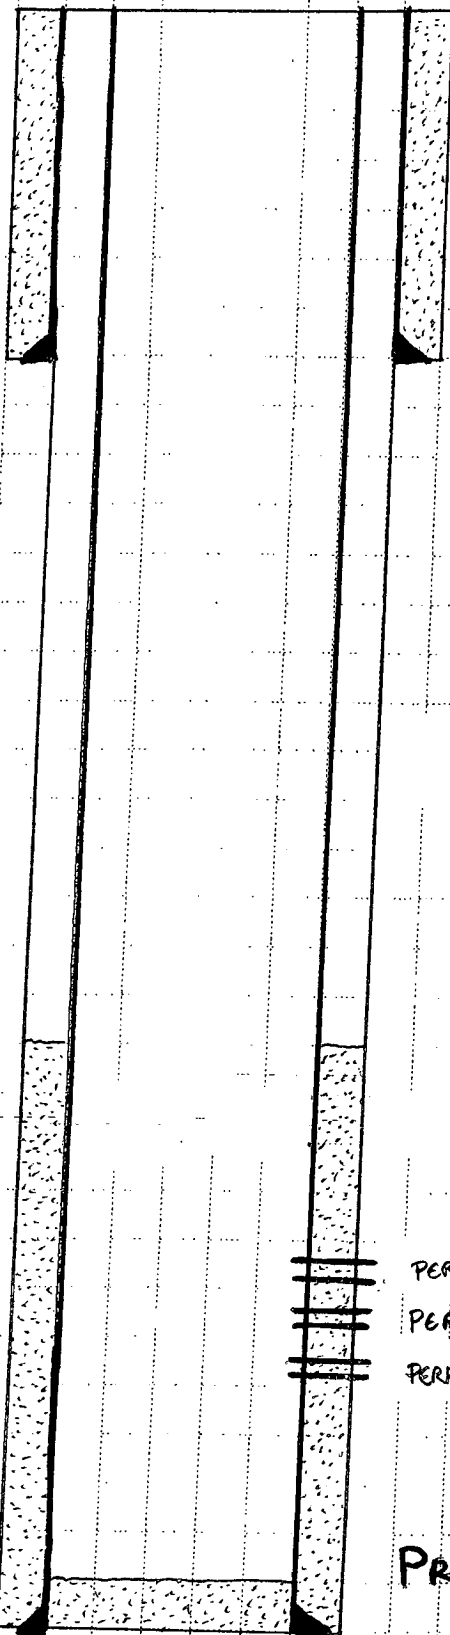

SURFACE CSG

8 5/8" 23 & 24 # K-55 @ 1,780'
CMT'D W/ 750 SXS CMT

TOC @ 5,076'

RECEIVED

SEP 28 2009

KCC WICHITA

PERFS 5,343' - 5,348' (MORROW)

PERFS 5,374' - 5,382' (MORROW)

PERFS 5,389' - 5,395' (MORROW)

PBD @ 5,565'

TD @ 5,650'

PRODUCTION CSG

5 1/2" 15.5 # J-55 @ 5650'
CMT'D W/ 100 SXS CMT



CORPORATION COMMISSION

Mark Parkinson, Governor Thomas E. Wright, Chairman Michael C. Moffet, Commissioner Joseph F. Harkins, Commissioner

NOTICE OF RECEIPT OF WELL PLUGGING APPLICATION (CP-1)

PRESCO WESTERN LLC
5665 FLATIRON PKWY
BOULDER, CO 80301

October 05, 2009

Re: Andrews Trust #9-C35-30-33
API 15-081-21817-00-00
35-30S-33W, 335 FNL 2308 FWL
HASKELL COUNTY, KANSAS

Dear Operator:

This letter is to notify you that the Conservation Division has received your plugging proposal, form CP-1, for the above well and has reviewed the proposal for completeness. The central office will now forward your CP-1 to the district office listed below for review of the proposed plugging method. **Please contact the district office for approval of your proposed plugging method at least five (5) days before plugging the well, pursuant to K.A.R. 82-3-113(b). If a workover pit will be used during the plugging of the well it must be permitted. A CDP-1 form must be filed and approved prior to the use of the pit in accordance with K.A.R. 82-3-600.**

The Conservation Division's review of form CP-1, either in the central or district office, does not include an inquiry into well ownership or the filing operator's legal right to plug the well. This notice in no way constitutes authorization to plug the above well by persons not having legal rights of ownership or interest in the well.

This notice is void after April 3, 2010. The CP-1 filing does not bring the above well into compliance with K.A.R. 82-3-111 with regard to the Commission's temporary abandonment requirements.

District: #1
210 E Frontview, Suite A
Dodge City, KS 67801
(620) 225-8888

Sincerely,

Steve Bond
Production Department Supervisor