
KANSAS CORPORATION COMMISSION OIL & GAS CONSERVATION DIVISION


WELL PLUGGING APPLICATION

Form CP-1 March 2009 This Form must be Typed Form must be Signed All blanks must be Filled

1

Please TYPE Form and File ONE Copy

OPERATOR: License #: <u>33725</u>	API No. 15 - 159-21154-0001
Name: Foundation Energy Managment, LLC	If pre 1967, supply original completion date:
Address 1: 14800 Landmark Blvd. Ste. 220	Spot Pescription:
Address 2:	<u> SE SE</u> Sec. <u>19</u> Twp. <u>20</u> S. R. <u>9</u> ☐ East West
City: Dallas State: TX zip: 75254 + 1 4 3	707 Feet from North / South Line of Section
Contact Person: David Koss	996 Feet from 🗹 East / 🗌 West Line of Section
Phone: (918_) _585-1650	Footages Calculated from Nearest Outside Section Corner:
	— NE NW ✓ SE SW
KICONT OPEN.	County: Rice Lease Name: Edward Malone Well #: 1
	thodic Water Supply Well Other:
SWD Permit #: ENHR Permit #:	
Conductor Casing Size: unknown Set at:	valent v
Surface Casing Size: 8-5/8" Set at: 211'	
Production Casing Size: 4-1/2" Set at: 3359'	
List (ALL) Perforations and Bridge Plug Sets:	Comoned was Cooks
Simpson - top perf around 3305', bridge plug set at 3255' Tarkio - top perf around 2215', bridge plug set at 2165'	
Elevation: 1770' (G.L./ [] K.B.) T.D.: 3360 PBTD: 3316' Anhydrite Depth:	
(Stone Cornel Formation) Condition of Well: Good Poor Junk in Hole ✓ Casing Leak at: <u>above 2165'</u>	
Proposed Method of Plugging (attach a separate page if additional space is needed):	(Interval)
Plug per KCC District 2 instructions	RECEIVED
	OCT 0 1 2009
Is Well Log attached to this application? Yes V No Is ACO-1 filed?	Yes No
If ACO-1 not filed, explain why:	KCC WICHITA
Plugging of this Well will be done in accordance with K.S.A. 55-101 et. seq. and the Rules and Regulations of the State Corporation Commission	
Company Representative authorized to supervise plugging operations: Cliff Cox	
Address: 601 S. Boulder Ave. Ste. 600	City: Tulsa
Phone: (405) 659-7804	
Plugging Contractor License #: 31529	
Address 1: P.O. Box 467	
City: Chase	State: KS Zip: 67524 + 0467
Phone: (620_) _562-8088	*/
Proposed Date of Plugging (if known): 10/15/09	- John
Payment of the Plugging Fee (K.A.R. 82-3-118) will be guaranteed by Operator or Agent	
Date: 9/28/2009 Authorized Operator / Agent: Jan	

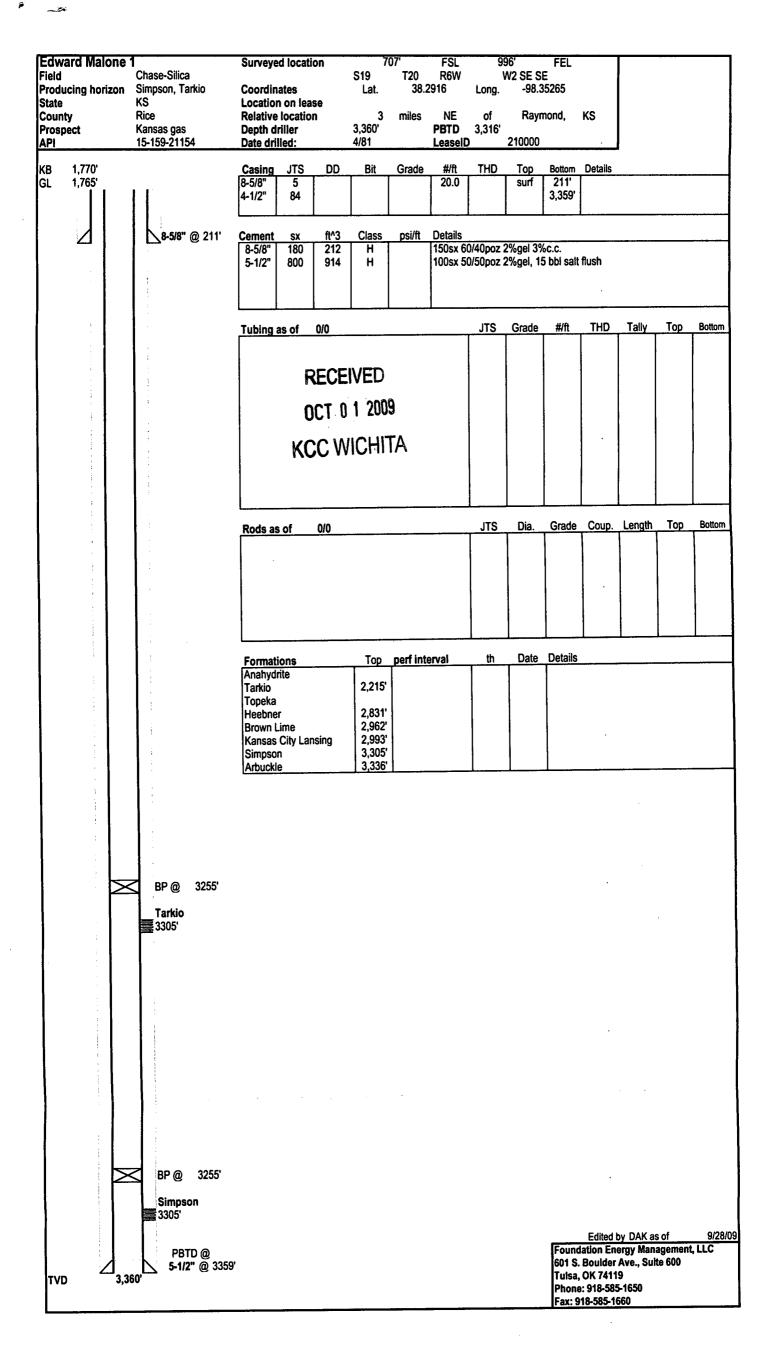



Mark Parkinson, Governor Thomas E. Wright, Chairman Michael C. Moffet, Commissioner Joseph F. Harkins, Commissioner

NOTICE OF RECEIPT OF WELL PLUGGING APPLICATION (CP-1)

• FOUNDATION ENERGY MANAGEMENT, LLC 14800 LANDMARK BLVD STE 220 DALLAS, TX 75254-1434 October 05, 2009

Re: MALONE EDWARD #1 API 15-159-21154-00-02 19-20S-9W, 707 FSL 996 FEL RICE COUNTY, KANSAS

Dear Operator:

The purpose of this letter is twofold. First, this letter is to notify you that the Conservation Division has received your plugging proposal, form CP-1, for the above well and has reviewed the proposal for completeness. The central office will now forward your CP-1 to the district office listed below for review of the proposed plugging method. Please contact the district office for approval of your proposed plugging method at least five (5) days before plugging the well, pursuant to K.A.R. 82-3-113(b). If a workover pit will be used during the plugging of the well it must be permitted. A CDP-1 form must be filed and approved prior to the use of the pit in accordance with K.A.R. 82-3-600.

This letter is also to notify you that during the central office's review of your CP-1 for license number verification, staff has discovered that you are not the current operator of record of the above well on file with the Conservation Division. Central office staff is therefore requesting that you verify that you are the operator of record of the above well. The proper procedure for verifying operator authority is by filing a Conservation Division form T-1 (Request for Change of Operator; Transfer of Injection or Surface Pit Permit). If a T-1 has already been filed with the Conservation Division reflecting the transfer of operator authority, please disregard this paragraph. If a T-1 has not been filed reflecting the transfer, please see the attached letter, which explains the T-1 filing process.

The Conservation Division's review of form CP-1, either in the central or district office, does not include an inquiry into well ownership or the filing operator's legal right to plug the well. Furthermore, this notice in no way constitutes authorization to plug the above well by persons not having legal rights of ownership or interest in the well.

This notice is void after April 3, 2010. The CP-1 filing does not bring the above well into compliance with K.A.R. 82-3-111 with regard to the Commission's temporary abandonment requirements.

Sincerely,

Steve Bond

Production Department Supervisor

Stue Bond

District: #2

3450 N. Rock Road, Suite 601

Wichita, KS 67226 (316) 630-4000