

STATE OF KANSAS
STATE CORPORATION COMMISSION

WELL PLUGGING RECORD

-Give All Information Completely
Make Required Affidavit
Mail or Deliver Report to:
Conservation Division
State Corporation Commission
800 Bittling Building
Wichita, Kansas

Rooks County. Sec. 8 Twp. 10S Rge. (E) 19 (W)

Location as "NE/CNW $\frac{1}{4}$ SW $\frac{1}{4}$ " or footage from lines NW/4 NW/4 NE/4

Lease Owner Heathman-Honaker Drilling Co., Inc.

Lease Name BARTOS Well No. 1

Office Address 510 Orpheum Building, Wichita, Kansas

Character of Well (completed as Oil, Gas or Dry Hole) dry hole

Date well completed 5-19- 19 49

Application for plugging filed 5-19- 19 49

Application for plugging approved 5-19- 19 49


Plugging commenced 5-19- 19 49

Plugging completed 5-19- 19 49

Reason for abandonment of well or producing formation ----

If a producing well is abandoned, date of last production ---- 19

Was permission obtained from the Conservation Division or its agents before plugging was commenced? yes

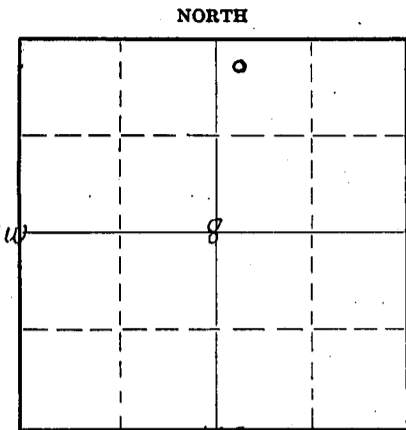

Name of Conservation Agent who supervised plugging of this well C. D. Stough

Producing formation none Depth to top --- Bottom --- Total Depth of Well 3833 Feet

Show depth and thickness of all water, oil and gas formations.

OIL, GAS OR WATER RECORDS

CASING RECORD

Formation	Content	From	To	Size	Put In	Pulled Out
none	---	---	---	8-5/8" surface	177.06'	none

Describe in detail the manner in which the well was plugged, indicating where the mud fluid was placed and the method or methods used in introducing it into the hole. If cement or other plugs were used, state the character of same and depth placed, from ---- feet to ---- feet for each plug set.

Filled hole with heavy mud, then
Set bottom plug @ 180' cemented with 15 sacks; filled hole up with mud to top plug 30' down; set top plug, cemented with 10 sacks to top of surface, surface pipe 6' in cellar.

RECEIVED

5-25-49
MAY 25 1949

STATE CORPORATION COMMISSION

(If additional description is necessary, use BACK of this sheet)

Correspondence regarding this well should be addressed to Heathman-Honaker Drilling Co., Inc.
Address 510 Orpheum Building, Wichita 2, Kansas

STATE OF Kansas, COUNTY OF Sedgwick ss.

H. D. Shreve (employee of owner) of the above-described well,

being first duly sworn on oath, says: That I have knowledge of the facts, statements, and matters herein contained and the log of the above-described well as filed and that the same are true and correct. So help me God. HEATHMAN-HONAKER DRILLING CO., INC.


(Signature) BY: H.D. Shreve

510 Orpheum Building, Wichita, Kansas
(Address)

SUBSCRIBED AND SWORN to before me this 24th day of May, 1949

D. Marguerite Matt
Notary Public.

My commission expires June 28, 1952.

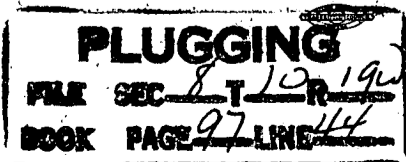

BARTOS # 1 WELL

Location: Approx. Ctr. NW/4 NW/4 NE/4 Sec. 8-10S-19W, Rooks County, Kansas Date Spudded: 5-5-49
 Rotary Completion date: 5-19-49
 Operator: Heathman-Honaker Drilling Co., Inc. Total Depth: 3833'
 Contractor: Heathman-Honaker Drilling Co., Inc. Elevation: 2225 DF - 2227 KB
 Surface Casing: 8 jts. (177.06' thds. off) 8-5/8" set @ 183' (6' in cell) w/125 sacks cement and 1 sack Calcium Chloride.
 Oil String: none run - Dry and abandoned at 3833' 5-19-49

T O P S (KB)

Anhydrite	1633
Heebner	3419
Lansing	3457 (-1230)
Conglomerate	3693 (-1466)
Simpson shale	3748
Arbuckle	3766 (-1539)
Total Depth	3833'

L O G

(Figures indicate bottom of formation)

Sand shale	0 to 183	Lime, shale conglomerate	3749
Shale and sand	1030	Lime and shale	3771
Sand and shale	1633	Lime	3783
Anhydrite	1657	Coring	3789
Anhydrite	1683	Lime and shale	3822
Shale shells	1810	Lime	3833'
Shale and shells	1945		
Shale and shells	2180		
Shale and lime	2345		
Shale and lime	3720	Total Depth	3833'

RECEIVED

MAY 25 1949

STATE OF KANSAS
 COMMISSIONER OF GEOLOGY

The undersigned, H. D. Shreve, of the Heathman-Honaker Drilling Co., Inc., hereby certified that the above log is a true and correct log of the formations encountered in drilling the above noted well as reflected by the Daily Drilling Reports.

PLUGGING
 FILE SEC 8 T 10 R 19W
 BOOK PAGE 97 LINE 14

HEATHMAN-HONAKER DRILLING CO., INC.

BY: H. D. Shreve
 H. D. Shreve

Subscribed and sworn to before me this 24th day of May, 1949.

D. Marguerite Mott
 Notary Public

My commission expires: June 28, 1952.