


### WELL PLUGGING RECORD

Give All Information Completely  
Make Required Affidavit  
Mail or Deliver Report to:  
Conservation Division  
State Corporation Commission  
800 Bitting Building  
Wichita, Kansas

NORTH

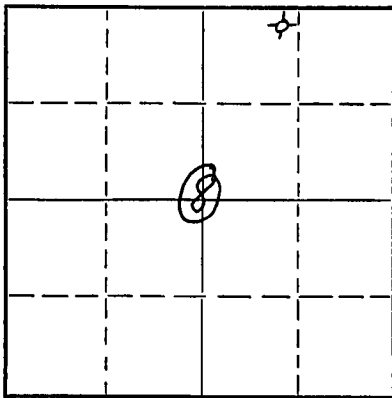

Locate well correctly on above  
Section Plat

Rooks County. Sec. 8 Twp. 10S Rge. 19 (E) (W)  
Location as "NE/CNW $\frac{1}{4}$ /SW $\frac{1}{4}$ " or footage from lines NE $\frac{1}{4}$  NW $\frac{1}{4}$  NE $\frac{1}{4}$   
Lease Owner W. N. Bartlett, et al  
Lease Name Bartos Well No. 1  
Office Address 300 Kaufman Building, Wichita 2, Kansas  
Character of Well (completed as Oil, Gas or Dry Hole) Dry Hole  
Date well completed June 8, 1952  
Application for plugging filed June 8, 1952  
Application for plugging approved June 8, 1952  
Plugging commenced June 8, 1952  
Plugging completed June 8, 1952  
Reason for abandonment of well or producing formation

If a producing well is abandoned, date of last production 19  
Was permission obtained from the Conservation Division or its agents before plugging was commenced? Yes

Name of Conservation Agent who supervised plugging of this well Eldon Petty  
Producing formation \_\_\_\_\_ Depth to top \_\_\_\_\_ Bottom \_\_\_\_\_ Total Depth of Well 3777 Feet  
Show depth and thickness of all water, oil and gas formations.

#### OIL, GAS OR WATER RECORDS

#### CASING RECORD

Formation	Content	From	To	Size	Put In	Pulled Out
	SURFACE CASING: 8-5/8" set at 184' with 125 sacks cement and 1 c.c.					

Describe in detail the manner in which the well was plugged, indicating where the mud fluid was placed and the method or methods used in introducing it into the hole. If cement or other plugs were used, state the character of same and depth placed, from \_\_\_\_\_ feet to \_\_\_\_\_ feet for each plug set.

15 sacks cement in bottom plug at 184'; 10 sacks cement on top plug set at 40'

(If additional description is necessary, use BACK of this sheet)


Correspondence regarding this well should be addressed to Birmingham-Bartlett Drilling Co.  
Address 300 Kaufman Building, Wichita, Kansas

STATE OF KANSAS, COUNTY OF SEDGWICK ss.  
Richard Hindery, partner of contractor, Birmingham-Bartlett Drilling Co. of the above-described well, being first duly sworn on oath, says: That I have knowledge of the facts, statements, and matters herein contained and the log of the above-described well as filed and that the same are true and correct. So help me God.  
Birmingham-Bartlett Drilling Co.  
(Signature) By: Richard Hindery  
300 Kaufman Building, Wichita, Kansas  
(Address)

SUBSCRIBED AND SWORN TO before me this 10th day of June, 1952

My commission expires November 29, 1954

RECEIVED  
Notary Public  
6-11-52

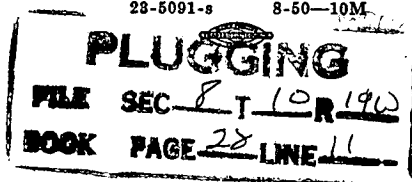

BARTOS #1 WELL

LOCATION: NE $\frac{1}{4}$  NW $\frac{1}{4}$  NE $\frac{1}{4}$  8-10S-19W  
Rooks County, Kansas

OPERATOR: Birmingham-Bartlett Drilling Co.

CONTRACTOR: Birmingham-Bartlett Drilling Co.

SURFACE CASING: 8-5/8" casing set at 185'  
with 125 sacks cement and 1 c.c.

OIL STRING: None D & A

SFUDDED: 5-29-52  
COMPLETED: 6-8-52

L O G

(Figures indicate bottom of formation)

0 to	80	Clay and Sand
	1025	Shale and Shells
	1080	Shale
	1300	Sand
	1615	Shale Redbed
	1655	Anhydrite
	1710	Shale
	2100	Shale and Shells
	2675	Lime and Shale
	3045	Shale and Shells
	3085	Shale
	3315	Lime and Shale
	3739	Lime
	3773	Conglomerate
	3777	Arbuckle
	3777	Total Depth

The undersigned, Richard Hindery of the Birmingham-Bartlett Drilling Co., hereby certifies that the above is a true and correct log of the formations encountered in drilling the Bartos #1 well as shown on the daily drilling reports.

BIRMINGHAM-BARTLETT DRILLING CO.

By Richard Hindery

Subscribed and sworn to before me this 10th day of June, 1952.

Virvian E. Genger  
Notary Public

My commission expires: November 29, 1954.

STATE OF KANSAS  
JUN 11 1952  
CONSERVATION DIVISION  

**PLUGGING**  
FILE SEC 8 T 10 R 19W  
BOOK PAGE 28 LINE 11