


STATE OF KANSAS  
STATE CORPORATION COMMISSION  
Give All Information Completely  
Make Required Affidavit  
Mail or Deliver Report to:  
Conservation Division  
State Corporation Commission  
800 Bittling Building  
Wichita, Kansas

WELL PLUGGING RECORD

Rooks County. Sec. 8 Twp. 10S Rge. 19 (W)  
Location as "NE/CNW $\frac{1}{4}$ SW $\frac{1}{4}$ " or footage from lines SW $\frac{1}{4}$  SW $\frac{1}{4}$  SE $\frac{1}{4}$   
Lease Owner Heathman Drilling Co., Inc., et al  
Lease Name HENDERSON Well No. 1  
Office Address 509 Orpheum Building, Wichita, Kansas  
Character of Well (completed as Oil, Gas or Dry Hole) dry hole  
Date well completed 3-13-50 19  
Application for plugging filed 3-13-50 19  
Application for plugging approved 3-13-50 19  
Plugging commenced 3-13-50 19  
Plugging completed 3-13-50 19  
Reason for abandonment of well or producing formation --- dry hole ---

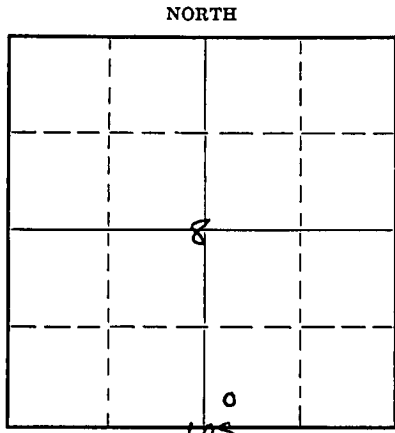

Locate well correctly on above Section Plat

If a producing well is abandoned, date of last production --- 19  
Was permission obtained from the Conservation Division or its agents before plugging was commenced? yes

Name of Conservation Agent who supervised plugging of this well Eldon Petty, Box 326, Hays, Kansas  
Producing formation --- Depth to top --- Bottom --- Total Depth of Well 3848 Feet  
Show depth and thickness of all water, oil and gas formations.

OIL, GAS OR WATER RECORDS

CASING RECORD

Formation	Content	From	To	Size	Put In	Pulled Out
none				8-5/8" (5 pts.)	132.96'	
				cement @	127.96' w/75	
				sacks and	1 sack C.C.	none pulled

Describe in detail the manner in which the well was plugged, indicating where the mud fluid was placed and the method or methods used in introducing it into the hole. If cement or other plugs were used, state the character of same and depth placed, from --- feet to --- feet for each plug set.

Filled hole with heavy mud ; set bottom hole plug @ 121' w/15 sacks cement; filled with heavy mud to 35' and set top hole plug w/10 sacks cement. Plugging completed about noon, 3-13-50.

3-18-50

(If additional description is necessary, use BACK of this sheet)  
Correspondence regarding this well should be addressed to Heathman Drilling Co., Inc.  
Address 509 Orpheum Bldg., Wichita, Kansas

STATE OF Kansas, COUNTY OF Sedgwick, ss.  
Robert F. Walters (employee of owner) of the above-described well, being first duly sworn on oath, says: That I have knowledge of the facts, statements, and matters herein contained and the log of the above-described well as filed and that the same are true and correct. So help me God. HEATHMAN DRILLING CO., INC.


(Signature) BY: Robert F. Walters  
509 Orpheum Bldg., Wichita, Kansas (Address)

SUBSCRIBED AND SWORN to before me this 17th day of March, 1950

June 28, 1952.

D. Marjorie Matt

Notary Public.

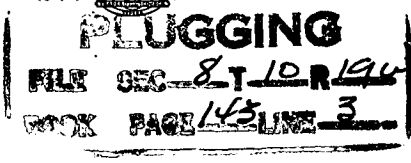

HENDERSON WELL NO. 1

Location: SW/4 SW/4 SE/4 Sec. 8-108-19W  
Rooks County, Kansas

Date Spudded: 3-2-50

Operator: Heathman Drilling Co., Inc.

Rotary Completion: 3-13-50

Contractor: Heathman Drilling Co., Inc.

Elevation: 2206' GR  
2208' DF  
2210' KB

Oil String: None run - dry and abandoned - 3-13-50

Surface Casing: 5 jts. (132.96') 8-5/8" @ 127.96'  
cemented with 75 sacks and 1 C.C.

Total Depth: 3848'

T O P S (KB)

Anhydrite	1620 (+ 590)
Topeka	3215 (-1005)
Haebner	3428 (-1218)
Lansing-K.C.	3468 (-1258)
Base K.C.	3678 (-1468)
Conglomerate	3747 (-1537)
Simpson	3769 (-1559)
Arbuckle	3832 (-1622)
Total Depth	3848'

L O G

(Figures indicate bottom of formation)

Sand and shale	0 to 1075
Sand	1357
Sand and shale	1620
Anhydrite	1654
Shale and shells	2092
Shale and lime shells	2238
Lime and shale	2880
Shale	3198
Shale and lime	3547
Lime	3675
Lime and shale	3718
Shale, lime and chert	3767
Chert	3810
Shale	3832
Dolomite	3848
Total Depth	3848'

RECEIVED  
MAR 13 1950

The undersigned, Robert F. Walters of Heathman Drilling Co., Inc., hereby certifies that the above log is a true and correct log of the formations encountered in the drilling of the above well as reflected by the Daily Drilling Reports.

HEATHMAN DRILLING CO., INC.

BY: Robert F. Walters  
Robert F. Walters

Subscribed and sworn to before me this 17th day of March 1950

D. Marjorie Mott  
Notary Public

My commission expires: June 28, 1952.

**PLUGGING**  
FILE SEC-RT 10 R194  
BOOK PAGE 143 LINE 3