

15-163-00087-0001


STATE OF KANSAS  
STATE CORPORATION COMMISSION

WELL PLUGGING RECORD

Give All Information Completely  
Make Required Affidavit  
Mail or Deliver Report to:  
Conservation Division  
State Corporation Commission  
212 North Market, Insurance Bldg.  
Wichita, Kansas

Rooks County, Sec. 9 Twp. 10 Rge. 19 (E) (W)  
Location as "NE/CNWxSWx" or footage from lines CN/2 NE/SE

T - 10 NORTH R - 19W

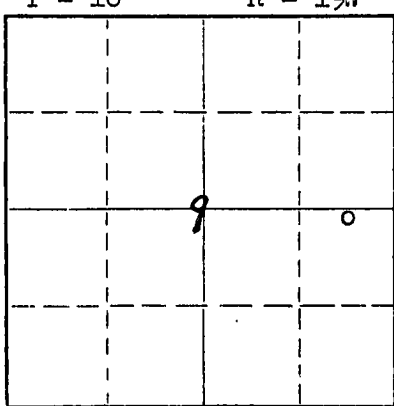

Locate well correctly on above Section Plat

Lease Owner Frank J. Black  
Lease Name Baldwin Well No. 1  
Office Address McPherson, Kansas  
Character of Well (completed as Oil, Gas or Dry Hole) Oil  
Date well completed 5-17 19 61  
Application for plugging filed 5-26 19 61  
Application for plugging approved 6-2 19 61  
Plugging commenced 6-14 19 61  
Plugging completed 6-17 19 61  
Reason for abandonment of well or producing formation Non-commercial

If a producing well is abandoned, date of last production 19  
Was permission obtained from the Conservation Division or its agents before plugging was commenced? Yes

Name of Conservation Agent who supervised plugging of this well Eldon Petty  
Producing formation \_\_\_\_\_ Depth to top \_\_\_\_\_ Bottom \_\_\_\_\_ Total Depth of Well 3771 Feet  
Show depth and thickness of all water, oil and gas formations.

OIL, GAS OR WATER RECORDS

CASING RECORD

FORMATION	CONTENT	FROM	TO	SIZE	PUT IN	PULLED OUT
				8 5/8	169	None
				5 1/2	3727	1006

Describe in detail the manner in which the well was plugged, indicating where the mud fluid was placed and the method or methods used in introducing it into the hole. If cement or other plugs were used, state the character of same and depth placed, from \_\_\_\_\_ feet to \_\_\_\_\_ feet for each plug set.

Set plug @ 3465'  
Top Perforation 3442

Sanded to 3430' - dumped 4 sks cement - pulled casing to 550' - pumped in 15 sks mud and 20 sks cement @ 550' - pulled casing to 170' - pumped in 20 sks cement - finished pulling casing - dumped 10 sks cement on top

RECEIVED  
STATE CORPORATION COMMISSION  
7-19-61  
JUL 19 1961  
CONSERVATION DIVISION  
Wichita, Kansas

Name of Plugging Contractor R & D Casing Pulling Co. License # 236  
Address Box # 572, Hutchinson, Kansas

STATE OF KANSAS, COUNTY OF MCPHERSON, ss.  
Frank J. Black (employer of owner) or (owner) or (operator) of the above-described well, being first duly sworn on oath, says: That I have knowledge of the facts, statements, and matters herein contained and the log of the above-described well as filed and that the same are true and correct. So help me God.  
(Signature) \_\_\_\_\_

SUBSCRIBED AND SWORN TO before me this 18th day of July, 19 61  
My commission expires July 16, 1963  
Jerry Peltzman  
JERRY PELTZMAN Notary Public.