


Give All Information Completely  
Make Required Affidavit  
Mail or Deliver Report to:  
Conservation Division  
State Corporation Commission  
212 North Market, Insurance Bldg.  
Wichita, Kansas

WELL PLUGGING RECORD

ROOKS County. Sec. 7 Twp. 10 Rge. 19 (X) W (W)

Location as "NE/CNW%SW%" or footage from lines SW SE SW  
Lease Owner C-G Drilling Company  
Lease Name ATHERTON Well No. 2  
Office Address 107 Rule Building Wichita, Kansas  
Character of Well (completed as Oil, Gas or Dry Hole) oil  
Date well completed April 17 19 61  
Application for plugging filed April 17 19 61  
Application for plugging approved April 17 19 61  
Plugging commenced April 17 19 61  
Plugging completed April 20 19 61  
Reason for abandonment of well or producing formation oil resevoir depleted.

NORTH

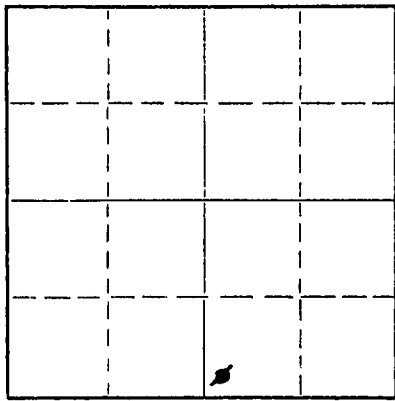

Locate well correctly on above  
Section Plat

If a producing well is abandoned, date of last production November 30, 19 60  
Was permission obtained from the Conservation Division or its agents before plugging was commenced? yes

Name of Conservation Agent who supervised plugging of this well Eldon Petty, Hays, Kansas.  
Producing formation \_\_\_\_\_ Depth to top \_\_\_\_\_ Bottom \_\_\_\_\_ Total Depth of Well 3769 Feet  
Show depth and thickness of all water, oil and gas formations.

OIL, GAS OR WATER RECORDS

CASING RECORD

FORMATION	CONTENT	FROM	TO	SIZE	PUT IN	PULLED OUT
				8 5/8	255	none
				5 1/2	3765	954'

Describe in detail the manner in which the well was plugged, indicating where the mud fluid was placed and the method or methods used in introducing it into the hole. If cement or other plugs were used, state the character of same and depth placed, from \_\_\_\_\_ feet to \_\_\_\_\_ feet for each plug set.

Plugged back to 3721' with 20' sand & 55 sacks cement.  
Pumped 20 sacks of gel & 20 sacks of cement.  
Pumped 20 sacks of cement  
Capped with 10 saks of cement.

RECEIVED  
STATE CORPORATION COMMISSION  
5-11-61  
1961  
CONSERVATION DIVISION  
Wichita, Kansas

(If additional description is necessary, use BACK of this sheet)

Name of Plugging Contractor PIPE PULLERS, INC.  
Address ELLINWOOD, KANSAS

STATE OF KANSAS COUNTY OF SEDGWICK, ss.  
G. F. Galloway (owner or operator) of the above-described well, being first duly sworn on oath, says: That I have knowledge of the facts, statements, and matters herein contained and the log of the above-described well as filed and that the same are true and correct. So help me God.

(Signature) G. F. Galloway  
107 Rule Building  
(Address)

SUBSCRIBED AND SWORN TO before me this 5th day of May, 19 61

My commission expires May 20, 1963  
Vicky Jacobs - Notary Public.



W E L L L O G

OPERATOR C-G Drilling Co.

SEC. 7-10-19W

WELL NAME Atherton #2

LOC. SW SE SW

TOTAL DEPTH 3772'

COUNTY Rooks

COM. June 18, 1949 Drilling COMP. June 30, 1949

STATE Kansas

RIG NO. 1

ELEVATION 2231' D.F.

CASING: Left in hole 257' (8 jts.) 8-5/8" OD Surface Casing. And 5-1/2" OD Casing 2811'

PRODUCTION: Abandoned

All measurements taken from the top of rotary bushing.

FROM	TO	FORMATION	DEVIATION FROM VERTICAL	REMARKS:
0	255	Lime & Shale		
255	817	Red Rock		
817	960	Shale & Shells		
960	1380	Sand & Shale		
1380	1646	Shale, Shells & Red Rock		
1646	1680	Anhydrite		
1680	1886	Shale & Red Rock		
1886	2010	Lime		
2010	2160	Shale & Lime		
2160	2495	Lime	0° - 2500	
2495	2525	Shale	0° - 2750	
2525	3340	Lime & Shale	0° - 3000	
3340	3370	Lime	0° - 3250	
3370	3425	Lime & Shale	0° - 3500	
3425	3772	Lime	0° - 3750	

RECEIVED STATE CORPORATION COMMISSION

MAY 21 1961

CONSERVATION DIVISION Wichita, Kansas

STATE OF KANSAS }  
COUNTY OF SEDGWICK } SS.

The undersigned hereby certifies that to the best of his knowledge and belief, the above facts are true and correct.

C-G DRILLING CO.

By G. F. Galloway  
G. F. Galloway

G. F. Galloway

SUBSCRIBED AND SWORN TO, BEFORE ME, THIS 9th day of May, 1961.

My commission expires: May 20, 1963

Vicky Jacobs  
Vicky Jacobs - Notary public

