


STATE OF KANSAS  
STATE CORPORATION COMMISSION  
200 Colorado Derby Bldg.  
Wichita, Kansas 67202

Form CP-4  
Rev. 12-15-80

WELL PLUGGING RECORD

Give All Information Completely  
Make Required Affidavit

COUNTY \_\_\_\_\_ ROOKS \_\_\_\_\_ SEC. 7 TWP. 10S RGE. 19W E/W  
Location as in quarters or footage from lines:  
SW SE NW \_\_\_\_\_

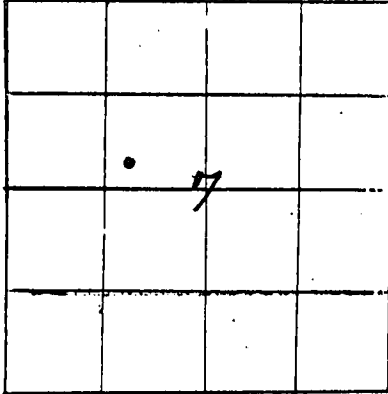

Locate Well  
correctly on above  
Section Platt.

Lease Owner Nadel and Gussman  
Lease Name OUDEKIRK Well No. 10  
Office Address 3232 First National Tower-Tulsa, OK 74103  
Character of Well (Completed as Oil, Gas or Dry Hole): oil  
Date Well Completed 11/28/51  
Application for plugging filed 9/23/82  
Plugging commenced 11/3/82  
Plugging completed 11/3/82  
Reason for abandonment of well or producing formation Depleted

Was permission obtained from the Conservation Division or it's  
Agent's before plugging was commenced? yes

Name of Conservation Agent who supervised plugging of this well Gilbert Scheck

Producing formation Arbuckle Depth to top 3764 bottom 3767 T.D. 3767

Show depth and thickness of all water, oil and gas formations.

OIL, GAS OR WATER RECORDS Casing Record

| Formation | Content | From | To   | Size    | Put in | Pulled Out |
|-----------|---------|------|------|---------|--------|------------|
| Arbuckle  | oil     | 3764 | 3767 | 10-3/4" | 148'   | none       |
|           |         |      |      | 5-1/2"  | 3764'  | none       |
|           |         |      |      |         |        |            |
|           |         |      |      |         |        |            |

Describe in detail the manner in which the well was plugged, indicating where the mud  
fluid was placed and the method or methods used in introducing it into the hold. If cement  
or other plugs were used, state the character of same and depth placed, from \_\_\_\_\_ feet  
to \_\_\_\_\_ feet for each plug set.

Perforated 625 ft. and 1600 ft.; plugged hole with 275 sacks cement, 250# psi

RECEIVED  
STATE CORPORATION COMMISSION  
11-10-82  
NOV 10 1982  
CONSERVATION DIVISION  
Wichita Kansas

(If additional description is necessary, use BACK of this sheet)

Name of Plugging Contractor Allied Cementing Company (Russell, Ks.)

STATE OF OKLAHOMA COUNTY OF TULSA, ss.  
M. R. Taylor, Mgr. of Production (employee of owner) or (owner or operator) of the  
above-described well, being first duly sworn on oath, says: That I have knowledge of the  
facts, statements, and matters herein contained and the log of the above-described well as  
filed and that the same are true and correct. So help me God.

(Signature) M R Taylor  
3232 First National Tower-Tulsa, OK 74103  
(Address)

SUBSCRIBED AND SWORN TO before me this 8th day of November, 1982

Mildred Carter  
Notary Public.

My Commission expires: 5/11/83

WELL LOG

Nadel and Gussman

Ouderkirk No. 10

SW SE NW 7-10-19W  
Rooks County, Kansas

Comm: 11-14-51  
Comp: 11-28-51

Casing: 10-3/4" 148' w/125 sax  
5-1/2" 3747' w/135 sax

| Formation                             | Depth |
|---------------------------------------|-------|
| Shale, sand                           | 155   |
| Shale                                 | 175   |
| Shale, shells, red bed & sand         | 1375  |
| Shale and shells                      | 1634  |
| Anhydrite                             | 1670  |
| Shale and shells                      | 2160  |
| Shale, broken lime                    | 2315  |
| Lime and shale                        | 2400  |
| Lime                                  | 2445  |
| Lime and shale                        | 3373  |
| Lime                                  | 3436  |
| Lime and shale                        | 3467  |
| Lime and Conglomerate                 | 3666  |
| Conglomerate, cherty                  | 3729  |
| Conglomerate, shale, Simpson dolomite | 3753  |
| Shale                                 | 3764  |
| Dolomite                              | 3767  |

| <u>Geological Tops</u> |      |
|------------------------|------|
| Heebner Shale          | 3425 |
| Toronto Lime           | 3446 |
| Lansing-K.C.           | 3464 |
| Conglomerate           | 3704 |
| Simpson Shale          | 3756 |
| Arbuckle               | 3764 |

RECEIVED  
STATE CORPORATION COMMISSION  
SEP 27 1952  
CONSERVATION DIVISION  
Wichita, Kansas

STATE OF KANSAS )  
                          ) SS:  
COUNTY OF SEDGWICK )

L. C. Hay, of lawful age, states that the above formations and depths are correct as taken from the daily drilling log of the Ouderkirk No. 10 in the SW SE NW 7-10-19W, Rooks County, Kansas.

L. C. Hay

Subscribed and sworn to before me this 3rd day of December, 1951.

Walter B. Babb  
Notary Public

My commission expires Nov. 3, 1952