

STATE OF KANSAS
STATE CORPORATION COMMISSION

WELL PLUGGING RECORD

Give All Information Completely
Make Required Affidavit
Mail or Deliver Report to:
Conservation Division
State Corporation Commission
800 Bitting Building
Wichita, Kansas


Rooks County. Sec. 7 Twp. 10 Rge. 19 (E) (W)

Location as "NE/CNW&SW" or footage from lines 990' East and 660' north
Lease Owner Nadel and Gussman (SW Cor. NW/4)

Lease Name Ouderkirk Well No. 12
Office Address 1714 First National Building, Tulsa, Oklahoma

Character of Well (completed as Oil, Gas or Dry Hole) Dry

Date well completed 9-24-55
Application for plugging filed 9-24-55
Application for plugging approved 9-24-55
Plugging commenced 9-24-55
Plugging completed 9-24-55
Reason for abandonment of well or producing formation Dry

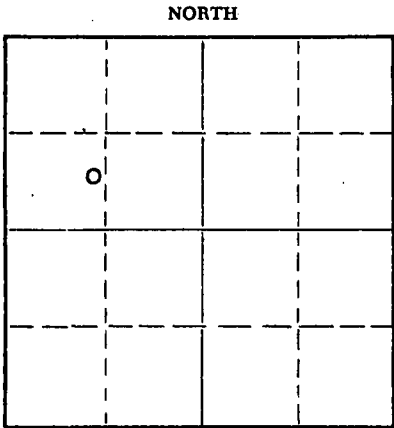

Locate well correctly on above Section Plat

If a producing well is abandoned, date of last production 19
Was permission obtained from the Conservation Division or its agents before plugging was commenced?

Name of Conservation Agent who supervised plugging of this well
Producing formation Depth to top Bottom Total Depth of Well 3828 Feet
Show depth and thickness of all water, oil and gas formations.

OIL, GAS OR WATER RECORDS

CASING RECORD

FORMATION	CONTENT	FROM	TO	SIZE	PUT IN	PULLED OUT
				8-5/8"	164'	0

Describe in detail the manner in which the well was plugged, indicating where the mud fluid was placed and the method or methods used in introducing it into the hole. If cement or other plugs were used, state the character of same and depth placed, from feet to feet for each plug set.

Filled hole from 3828 to 160' with heavy mud - set plug with 15 sacks cement. Filled hole to 40' and set top plug with 10 sacks cement.

RECEIVED
STATE CORP. COM.
9-30-55
SEIZURE
CONSERVATION DIVISION
Wichita, Kansas

(If additional description is necessary, use BACK of this sheet)
Name of Plugging Contractor Reserve Drilling Company, Inc.
Address 703 Union National Building, Wichita 2, Kansas

STATE OF KANSAS, COUNTY OF SEDGWICK, ss.
L. C. Hay (employee of owner) of the above-described well, being first duly sworn on oath, says: That I have knowledge of the facts, statements, and matters herein contained and the log of the above-described well as filed and that the same are true and correct. So help me God.

(Signature) L. C. Hay
Wichita, Kansas (Address)

SUBSCRIBED AND SWORN TO before me this 26th day of September, 19 55

Notary Public. Nora Babb

My commission expires Nov. 3, 1956

PLUGGING
PLI SEC 7 T 10 R 19W
BOOK PAGE 3 LINE 35

WELL LOG

Nadel and Gussman

Ouderkirk No. 12

Cent. E. Line SW NW
Sec. 7-10-19W
Rooks County, Kansas

Comm: 9-15-55
Comp: 9-24-55

Casing: 8-5/8" 164' w/125 sex

<u>Formations</u>	<u>Depth</u>
Surface	166
Shale and shells	760
Shale and sand	1130
Sand	1360
Shale and shells	1640
Anhydrite	1685
Shale and shells	2190
Shale and lime	2495
Broken lime	2615
Shale and lime	2905
Broken lime	2970
Shale and lime	3307
Lime	3385
Lime and shale	3475
Lime	3775
Conglomerate	3828

Geological Tops

Heebner	3450
Toronto Lime	3468
Lansing-K.C.	3488
Base Kansas City	3699
Shaley Conglomerate	3736
Chart Conglomerate	3779

STATE OF KANSAS }
COUNTY OF SEDGWICK } SS:

L. C. Hay, of lawful age, states that the above formations and depths are correct as shown by the daily drilling log of the Ouderkirk No. 12 in the Center East line SW NW 7-10-19W, Rooks County, Kansas.

L. C. Hay
L. C. Hay

Subscribed and sworn to before me this 26th day of September, 1955.

Wela Babb
Wela Babb
Notary Public

My commission expires Nov. 3, 1956

PLUGGING
FILE SEC 7-10-19W
BOOK PAGE 3 LINE 35