

15-163-01907-0000


STATE OF KANSAS
STATE CORPORATION COMMISSION
200 Colorado Derby Bldg.
Wichita, Kansas 67202

Form CP-4
Rev. 12-15-80

WELL PLUGGING RECORD

Give All Information Completely
Make Required Affidavit

COUNTY Rooks SEC. 7 TWP. 10S RGE. 19W E/W
Location as in quarters or footage from lines:
SW SW NE

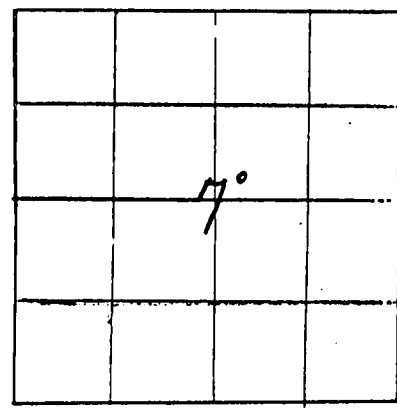

Locate Well
correctly on above
Section Platt.

Lease Owner Nadel and Gussman
Lease Name OUDEKIRK Well No. 2
Office Address 3232 First National Tower-Tulsa, OK 74103
Character of Well (Completed as Oil, Gas or Dry Hole): oil
Date Well Completed 6/20/49
Application for plugging filed 9/23/82
Plugging commenced 11/3/82
Plugging completed 11/3/82
Reason for abandonment of well or producing formation

Depleted
Was permission obtained from the Conservation Division or it's
Agent's before plugging was commenced? yes

Name of Conservation Agent who supervised plugging of this well Gilbert Scheck
Producing formation Arbuckle Depth to top 3776 bottom 3782 T.D. 3782
Show depth and thickness of all water, oil and gas formations.

OIL, GAS OR WATER RECORDS Casing Record

Formation	Content	From	To	Size	Put in	Pulled Out
Arbuckle	oil	3776	3782	8-5/8"	191'	none
				5-1/2"	3777'	none

Describe in detail the manner in which the well was plugged, indicating where the mud
fluid was placed and the method or methods used in introducing it into the hold. If cement
or other plugs were used, state the character of same and depth placed, from _____ feet
to _____ feet for each plug set.

Perforated 630' and 1650 ft.; plugged hole with 275 sacks cement; 200# psi

RECEIVED
STATE CORPORATION COMMISSION
11-10-82
NOV 10 1982
CONSERVATION DIVISION
Wichita, Kansas

(If additional description is necessary, use BACK of this sheet)
Name of Plugging Contractor Allied Cementing (Russell, Ks.)

STATE OF OKLAHOMA COUNTY OF TULSA, ss.
M. R. Taylor, Mgr. of Production (employee of owner) or (owner or operator) of the
above-described well, being first duly sworn on oath, says: That I have knowledge of the
facts, statements, and matters herein contained and the log of the above-described well as
filed and that the same are true and correct. So help me God.

(Signature) M R Taylor
3232 First National Tower-Tulsa, OK 74103
(Address)

SUBSCRIBED AND SWORN TO before me this 8th day of November, 19 82

Mildred Carter
Notary Public.

My Commission expires: 5/11/83

WELL LOG

NADEL AND GUSSMAN

OUDEKIRK No. 2

SW NE 7-10-19W
Rooks County, Kansas

Commenced 6-6-49
Completed 6-20-49

Elevation 2224

Formation	Depth
Clay and sand	160
Shale and shells	191
Shale and shells	1100
Sand	1355
Shale	1640
Anhydrite	1680
Shale	1720
Shale and shells	2200
Shale and Limestone	2305
Shale and limestone shells	2405
Broken Lime	2490
Lime	2575
Shale and limestone	2745
Lime	2795
Shale and limestone	3135
Lime	3145
Shale and limestone	3280
Limestone	3714
Conglomerate	3776
Lime	3782

Casing: 8" 191' - 185 sax Cem.
5 1/2" 3777' - 125 sax Cem.

TOPS

Top	Depth
Topeka	3225
Heebner	3435
Dodge	3453
Lansing-Kansas C.	3473
Cherty Cong.	3714
Simpsons Dolo.	3765
Arbuckle	3776

STATE OF KANSAS)
) SS:
COUNTY OF SEDGWICK)

L. C. Hay, of lawful age, being first duly sworn on his oath deposes and states and the above formations and depths are true and correct as taken from the daily drilling log.

L. C. Hay

Subscribed and sworn to before me this 22nd day of June, 1952.

Notary Public

My commission expires Nov. 3, 1952

NOT RECEIVED
STATE CORPORATE COMMISSION

SEP 27 1962

CONSERVATION DIVISION
WICHITA, KANSAS