

15-163-02552-0000

STATE OF KANSAS
STATE CORPORATION COMMISSION

WELL PLUGGING RECORD

Give All Information Completely
Make Required Affidavit
Mail or Deliver Report to:
Conservation Division
State Corporation Commission
800 Bitting Building
Wichita, Kansas

Rooks County, Sec. 7 Twp. 10 Rge. 19 (E) W (W)

Location as "NE/CNW/SW" or footage from ~~NE/SE/NW~~ NE SE NW

Lease Owner Nadel and Gussman

Lease Name Ouderkirk Well No. 11

Office Address P. O. Box 309, Tulsa, Oklahoma

Character of Well (completed as Oil, Gas or Dry Hole) Dry

Date well completed 8-6-1952

Application for plugging filed 8-6-1952

Application for plugging approved 8-6-1952

Plugging commenced 8-6-1952


Plugging completed 8-6-1952

Reason for abandonment of well or producing formation _____

Dry

If a producing well is abandoned, date of last production _____ 19____

Was permission obtained from the Conservation Division or its agents before plugging was commenced? Yes

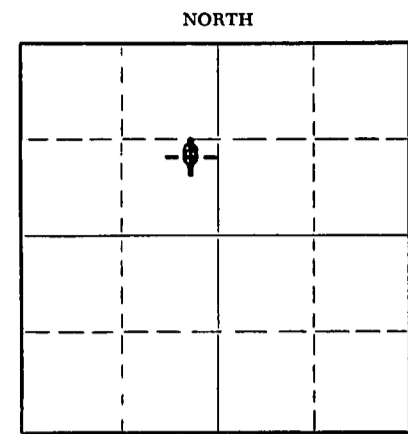

Locate well correctly on above Section Plat

Name of Conservation Agent who supervised plugging of this well Eldon Petty

Producing formation _____ Depth to top _____ Bottom _____ Total Depth of Well 3855 Feet

Show depth and thickness of all water, oil and gas formations.

OIL, GAS OR WATER RECORDS

CASING RECORD

FORMATION	CONTENT	FROM	TO	SIZE	PUT IN	PULLED OUT
				10-3/4	145	0

Describe in detail the manner in which the well was plugged, indicating where the mud fluid was placed and the method or methods used in introducing it into the hole. If cement or other plugs were used, state the character of same and depth placed, from _____ feet to _____ feet for each plug set.

Filled hole from 3855 to 135' with heavy rotary mud - set plug a 135' and cemented with 20 sax of cement/ Filled with mud to 35', set plug and cemented with 10 sax cement.

RECEIVED
STATE CORPORATION COMMISSION
8-13-52
AUG 13 1952

CONSERVATION DIVISION
Wichita, Kansas

Name of Plugging Contractor Reserve Drilling Company, Inc.

Address 703 Union National Bank Bldg. Wichita, Kansas

STATE OF KANSAS, COUNTY OF SEDGWICK, ss.

L. C. Hay (employee of owner) or (~~owner or operator~~) of the above-described well, being first duly sworn on oath, says: That I have knowledge of the facts, statements, and matters herein contained and the log of the above-described well as filed and that the same are true and correct. So help me God.

(Signature) L. C. Hay

(Address) _____

SUBSCRIBED AND SWORN TO before me this 11th day of August 1952

Nola Petty
Notary Public.

My commission expires Nov. 3, 1952

24-2675-S 2-52-20M

PLUGGING
FILE SEC 7 T 10 R 1952
BOOK PAGE 37 LINE 2

15-163-02552-0000

WELL LOG

Nadel and Gussman

OUDEKIRK NO. 11

NE SE NW 7-10-19W
Rooks County, Kansas

Comm: 7-26-52
Comp: 8-6-52

Casing: 10" 145' w/100 sax

Formations	Depth
Surface	145
Shale and shells	600
Shale, shells and sand	1450
Sand and shale	1647
Anhydrite	1686
Shale and shells	1726
Broken lime, shds & red bed	1905
Shale and broken lime	2130
Broken lime	2330
Lime and shale	2545
Shale and shells	2645
Lime and shale	3466
Lime	3670
Lime, shale and Cong.	3735
Lime and Cong.	3773
Cong.	3823
Shale	3834
Dolomite	3855

GEOLOGICAL TOPS

Heebner Shale	3448
Toronto Lime	3469
Lansing-Kansas City	3487
Base Kansas City	3699
Conglomerate	3740
Simpson shale	3820
Arbuckle	3834
T.D.	3855

PLUGGING

FILE SEC 7-10-19W
BOOK PAGE 37 LINE 2

STATE OF KANSAS

COUNTY OF SEDGWICK

} 85:

L. C. Hay, of lawful age, deposes and states that the above formations and depths are correct as shown by the daily drilling log of the Ouderkirk No. 11 Well in the NE SE NW 7-108-19W, Rooks County, Kansas.

CONSERVATION DIVISION
STATE OF KANSAS

Subscribed and sworn to before me this 11th day of August, 1952.

L. C. Hay
Notary Public

My commission expires Nov. 3, 1952