


15-163-02465-0000

STATE OF KANSAS
STATE CORPORATION COMMISSION

WELL PLUGGING RECORD

Give All Information Completely
Make Required Affidavit
Mail or Deliver Report to:
Conservation Division
State Corporation Commission
800 Bitting Building
Wichita, Kansas

NORTH

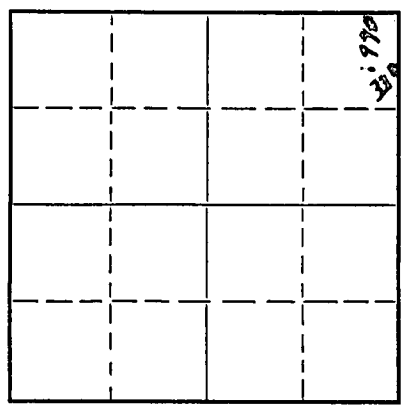

Locate well correctly on above
Section Plat

..... Rooks County. Sec. 9 Twp. 10 Rge. 19 ~~NE/SE~~
Location as "NE/CNW $\frac{1}{4}$ SW $\frac{1}{4}$ " or footage from lines NE/SE/NW 330'E 990'N
Lease Owner Grant Oil Co.
Lease Name Baldwin Well No. A-1
Office Address 507 W.K.H. Bldg., Wichita, Kans.
Character of Well (completed as Oil, Gas or Dry Hole) dry hole
Date well completed..... 19.....
Application for plugging filed June 17, 1953..... 19.....
Application for plugging approved June 19, 1953..... 19.....
Plugging commenced June 19, 1953..... 19.....
Plugging completed June 24, 1953..... 19.....
Reason for abandonment of well or producing formation dry hole
If a producing well is abandoned, date of last production dry hole..... 19.....
Was permission obtained from the Conservation Division or its agents before plugging was commenced? yes

Name of Conservation Agent who supervised plugging of this well Eldon Petty
Producing formation Arbuckle Depth to top 3745' Bottom 3750' Total Depth of Well 3750' Feet
Show depth and thickness of all water, oil and gas formations.

OIL, GAS OR WATER RECORDS

CASING RECORD

Formation	Content	From	To	Size	Put In	Pulled Out
<u>surface</u>	<u>water</u>	<u>0</u>	<u>160</u>	<u>8 5/8</u>	<u>160'</u>	<u>none</u>
<u>Arbuckle</u>	<u>water</u>	<u>3745</u>	<u>3750</u>	<u>5 1/2</u>	<u>3745</u>	<u>2926</u>

Describe in detail the manner in which the well was plugged, indicating where the mud fluid was placed and the method or methods used in introducing it into the hole. If cement or other plugs were used, state the character of same and depth placed, from.....feet to.....feet for each plug set.

Dumped 5 sacks of cement in bottom of hole. Filled After pipe was pulled filled hole with mud to 160'. Put in 10' of rock bridge. Mixed and run 15 sacks of cement. Filled hole with mud to 35'. put in 5 feet of rock bridge. Mixed and ran 10 sacks of cement. Filled to bottom of cellar which is 4 feet below surface.

(If additional description is necessary, use BACK of this sheet)

Correspondence regarding this well should be addressed to Grant Oil Co.
Address 507 W.K.H. Bldg.,
Wichita, Kansas.

STATE OF Kansas, COUNTY OF Rooks, ss.
L. Paul Pfeifer (employee of owner) or (owner or operator) of the above-described well, being first duly sworn on oath, says: That I have knowledge of the facts, statements, and matters herein contained and the log of the above-described well as filed and that the same are true and correct. So help me God.

(Signature) Paul Pfeifer
(Address)

SUBSCRIBED AND SWORN to before me this 9th day of July 1953

My commission expires 9-4-54 Ray Gillig Notary Public.

23-5091-s 8-50-10M

PLUGGING
FILED SEC 9-10-1953
BOOK 108 PAGE 43

RECEIVED
7-14-53
JUL 14 1953
CONSERVATION DIVISION
Wichita, Kansas

BALDWIN "A"-1

NE/4 SE/4 NW/4 Sec. 9-10-19W, Rooks County, Kansas

Rigged up Rotary Tools 5/20/53
Tore down Rotary Tools 5/31/53


Set 8 5/8" casing at 160' with 150 sx cement
Set 5 1/2" casing at 3745' with 100 sx cement

<u>FORMATION</u>	<u>FROM</u>	<u>TO</u>
Surface sand and clay	0	60
Shale and shells	60	835
Sand	835	885
Shale and shells	885	916
Shale	916	1065
Sand	1065	1335
Red bed and shale	1335	1500
Red bed	1500	1590
Anhydrite	1590	1626
Shale and shells	1626	2280
Shale and lime	2280	3070
Shale and shells	3070	3280
Lime and shale	3280	3439
Lime	3439	3468
Lime and shale	3468	3520
Lime	3520	3675
Cherty Cong.	3675	3716
Cong.	3716	3750 Total Depth

I, W. A. Grant, hereby certify that the above Log is true and correct to the best of my knowledge and belief.



Subscribed and sworn to before me this 18th day of June, 1953.

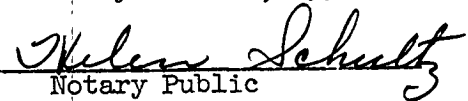
Notary Public

My commission expires: Feb. 29, 1956

RECEIVED
STATE CORPORATION COMMISSION
JUL 14 1953
CONSERVATION DIVISION
Wichita, Kansas

PLUGGING
WJ SEC 9 T 10 R 19W
BOOK PAGE 108 LINE 43