

15-163-20205-0000

STATE OF KANSAS
STATE CORPORATION COMMISSION

Form CP-4

WELL PLUGGING RECORD

Give All Information Completely
Make Required Affidavit
Mail or Deliver Report to:
Conservation Division
State Corporation Commission
212 No. Market
Wichita, Kansas

Rooks County. Sec. 9 Twp. 10 Rge. 19 (E) W (W)

Location as "NE/CNW/SW" or footage from lines C-N/2 N/2 SE

Lease Owner Leo J. Dreiling Oil Company

Lease Name Baldwin B # 33 Well No. 1

Office Address Route # 2 Victoria, Kansas

Character of Well (completed as Oil, Gas or Dry Hole) Dry

Date well completed 9-24-1966

Application for plugging filed 9-24-1966

Application for plugging approved 9-24-1966


Plugging commenced 9-24-1966

Plugging completed 9-24-1966

Reason for abandonment of well or producing formation Dry

If a producing well is abandoned, date of last production 19

Was permission obtained from the Conservation Division or its agents before plugging was commenced? YES

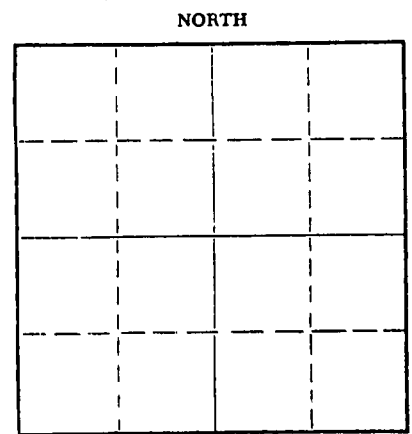

Name of Conservation Agent who supervised plugging of this well Leo Massey

Producing formation Depth to top Bottom Total Depth of Well 3755' Feet

Show depth and thickness of all water, oil and gas formations.

OIL, GAS OR WATER RECORDS

CASING RECORD

FORMATION	CONTENT	FROM	TO	SIZE	PUT IN	PULLED OUT
SURFACE PIPE				8-5/8"	166'	

Describe in detail the manner in which the well was plugged, indicating where the mud fluid was placed and the method or methods used in introducing it into the hole. If cement or other plugs were used, state the character of same and depth placed, from feet to feet for each plug set.

Filled hole with Rotary mud to a depth of 540' where 1st plug was set using 25 sax cement. Filling hole with rotary mud to a depth of 160' where 2nd plug was set using 20 sax cement. Rotary mud was used to fill hole to a depth of 40' where 3rd plug was set using 8 sks cement and filling hole to surface.

RECEIVED
STATE CORPORATION COMMISSION
9-30-66
SEP 30 1966

Name of Plugging Contractor L. J. Dreiling & Sons, Inc.
Address Route # 2 Victoria, Kansas 67671

STATE OF KANSAS, COUNTY OF ELLIS, ss. L, Leo F. Dreiling (employee of owner) of the above-described well, being first duly sworn on oath, says: That I have knowledge of the facts, statements, and matters herein contained and the log of the above-described well as filed and that the same are true and correct. So help me God.

(Signature) Leo F. Dreiling
Route # 2 Victoria, Kansas
(Address)

SUBSCRIBED AND SWORN to before me this 26th day of September, 19 66

My commission expires October 26, 1968
ELMER WELTZ Notary Public.

L. J. DREILING and SONS, Inc.
VICTORIA, KANSAS

WELL LOG

Company Leo J. Dreiling Oil Company
Victoria, Kansas
Farm Baldwin "B" No. 1
Total Depth 3755'
Comm. 9-16-66 Comp. 9-24-66
Contractor L.J. Dreiling & Sons, Inc.
Victoria, Kansas

Sec. 9 Twp. 10 Rng. 19
Location C-N/2 N/2 SE
County Rooks
2213' K.B.
Elevation: 2210' D. F.
2208' G. R.

Casing Record Cement Record
166' 8-5/8" 125 sacks

Production:
D & A

RECEIVED
OIL CORPORATION COMMISSION
SEP 20 1966

Figures Indicate Bottom of Formations

0'	30'	Surface Soil & Clay
30'	95'	Sand
95'	166'	Shale
166'	462'	Shale
462'	1055'	Shale & Shells
1055'	1285'	Sand
1285'	1575'	Shale & Shells
1575'	1605'	Anhy.
1605'	1616'	Anhy.
1616'	2155'	Shale & Shells
2155'	2389'	Shale & Lime
2389'	2650'	Lime & Shale
2650'	2850'	Lime & Shale
2850'	3052'	Lime & Shale
3052'	3260'	Lime & Shale
3260'	3338'	Lime
3338'	3349'	Lime
3349'	3435'	Lime
3435'	3465'	Lime
3465'	3480'	Lime
3480'	3505'	Lime
3505'	3530'	Lime
3530'	3581'	Lime
3581'	3605'	Lime
3605'	3655'	Lime
3655'	3714'	Lime & Chert
3714'	3741'	Lime
3741'	3755'	Lime

STATE OF KANSAS)
)ss
COUNTY OF ELLIS)

I, Leo F. Dreiling, of the L. J. Dreiling & Sons, Inc. upon oath states that the above and foregoing is a true and correct copy from the Daily Drilling Report from your Baldwin B # 1.

Leo F. Dreiling
LEO F. DREILING

Subscribed and sworn to before me this 26th day of September 1966.

Eileen Wells
NOTARY PUBLIC

My commission expires: October 26th, 1968