


15-163-04062-0000

STATE OF KANSAS
STATE CORPORATION COMMISSION

WELL PLUGGING RECORD

Give All Information Completely
Make Required Affidavit
Major Deliver Report to:
Conservation Division
State Corporation Commission
212 North Market, Insurance Bldg.
Wichita, Kansas

Rooks County. Sec. 9 Twp. 10 Rge. (E) 19 (W)
Location as "NE/CNW/SW" or footage from lines SW7NE7SE
Lease Owner Frank J. Black
Lease Name Baldwin Well No. 2
Office Address McPherson, Kansas
Character of Well (completed as Oil, Gas or Dry Hole) Oil
Date well completed 4-21 1948
Application for plugging filed 5-26 1961
Application for plugging approved 6-2 1961
Plugging commenced 6-9 1961
Plugging completed 6-13 1961
Reason for abandonment of well or producing formation Non-commercial

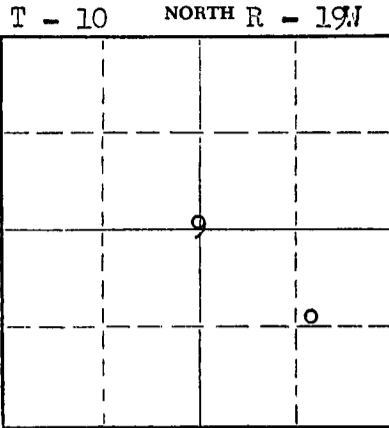

Locate well correctly on above
Section Plat

If a producing well is abandoned, date of last production 19
Was permission obtained from the Conservation Division or its agents before plugging was commenced? Yes

Name of Conservation Agent who supervised plugging of this well Eldon Petty
Producing formation _____ Depth to top _____ Bottom _____ Total Depth of Well 3753 Feet
Show depth and thickness of all water, oil and gas formations.

OIL, GAS OR WATER RECORDS

CASING RECORD

FORMATION	CONTENT	FROM	TO	SIZE	PUT IN	PULLED OUT
				10 3/4	159	None
				5 1/2	3746	680

Describe in detail the manner in which the well was plugged, indicating where the mud fluid was placed and the method or methods used in introducing it into the hole. If cement or other plugs were used, state the character of same and depth placed, from _____ feet to _____ feet for each plug set.

Plug @ 3577'
Top Perforation 3456

Sanded hole to 3445' - dumped 4 sks cement - pulled casing to 550' - pumped 20 sks mud and 20 sks cement through casing @ 550' - pulled pipe to 170' - pumped in 20 sks cement - finished pulling casing

RECEIVED
STATE CORPORATION COMMISSION
7-19-61
JUL 19 1961
CONSERVATION DIVISION
Wichita, Kansas

(If additional description is necessary, use BACK of this sheet)

Name of Plugging Contractor R & D Casing Pulling Company License # 236
Address Box # 572, Hutchinson, Kansas

STATE OF KANSAS, COUNTY OF MCPHERSON, ss.
Frank J. Black (employee of owner) or (owner or operator) of the above-described well, being first duly sworn on oath, says: That I have knowledge of the facts, statements, and matters herein contained and the log of the above-described well as filed and that the same are true and correct. So help me God.
(Signature) [Signature]

SUBSCRIBED AND SWORN TO before me this 18th day of July, 1961

My commission expires July 16, 1963
Jerry Peltzman
JERRY PELTZMAN
Notary Public.



Re

KANSAS GEOLOGICAL SOCIETY
401 West 12th Street, O.H.G. Wichita, Kansas


COPY

Company HARBAR OIL COMPANY
Farm Baldwin No. 2

SEC. 9 T. 10 R. 19W
SW NE SE

Total Depth. 3753'
Com. 4-4-48
Spore of Fr. recd.
Contractor
dated. 7-17-48

County. Rocks
KANSAS

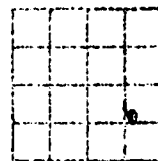

CASING:

10-3/4" 159' Cem. w/150 sx
5" 3746' Cem. w/ 75 sx

Elevation.

Production. Pot. 124 BO

Flow rate to Bottom of Fracture...

clay	0-10
sand	20
clay, shale & shells	159
shale & shells	640
sand	750
shale & sand	850
sand	970
sand & shale	1050
sand	1300
red bed & shale	1560
shale & shells	1640
red bed	1710
shale & shells	2200
shale & lime	2900
shale	3085
shale & lime	3420
lime	3523
lime & shale	3565
lime	3638
lime & chert	3678
chert	3698
shale	3735
lime & chert	3753
Total Depth	

Tops:

Topeka	3168
Lancing	3423
Base Penn. Conglomerat	3664
arbuckle	3744

RECEIVED
STATE CORPORATION COMMISSION
JUL 19 1961
CONSERVATION DIVISION
Wichita, Kansas