


15-163-03284-000

STATE OF KANSAS
STATE CORPORATION COMMISSION

WELL PLUGGING RECORD

Give All Information Completely
Make Required Affidavit
Mail or Deliver Report to:
Conservation Division
State Corporation Commission
800 Bittling Building
Wichita, Kansas

Rooks County. Sec. 7 Twp. 10 Rge. 19 (X) W (W)
Location as "NE/CNW/SW" or footage from lines SW NW SW
Lease Owner C-G Drilling Company
Lease Name Dunlap Well No. 5
Office Address 544 Petroleum Bldg. - Wichita, Kansas
Character of Well (completed as Oil, Gas or Dry Hole) Oil
Date well completed 7-24 1951
Application for plugging filed _____ 19____
Application for plugging approved _____ 19____
Plugging commenced March 6 1954
Plugging completed March 9 1954
Reason for abandonment of well or producing formation Non-Commercial

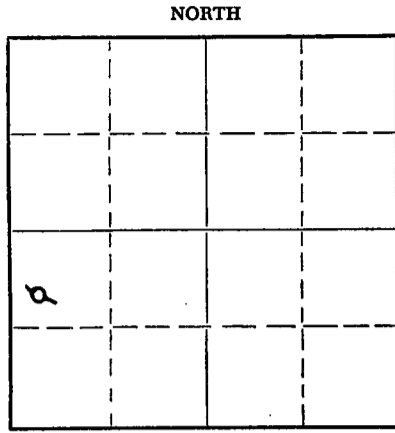

Locate well correctly on above
Section Plat

If a producing well is abandoned, date of last production March 1 1954
Was permission obtained from the Conservation Division or its agents before plugging was commenced? Yes

Name of Conservation Agent who supervised plugging of this well Eldon Petty
Producing formation _____ Depth to top _____ Bottom _____ Total Depth of Well 3785' Feet
Show depth and thickness of all water, oil and gas formations.

OIL, GAS OR WATER RECORDS

CASING RECORD

FORMATION	CONTENT	FROM	TO	SIZE	PUT IN	PULLED OUT
				8-5/8"	190'	None
				4-1/2"	3783'	595'

Describe in detail the manner in which the well was plugged, indicating where the mud fluid was placed and the method or methods used in introducing it into the hole. If cement or other plugs were used, state the character of same and depth placed, from _____ feet to _____ feet for each plug set.

Filled hole with sand from 3785' to 3775'
and ran 3 sacks of cement. Mudded hole to
190', set a 10' rock bridge and ran 15
sacks of cement at 180'. Mudded hole to 40'
set a 10' rock bridge and ran 10 sacks of
cement on top. Plugging completed.

(If additional description is necessary, use BACK of this sheet)

Name of Plugging Contractor West Supply Company
Address Chase, Kansas

STATE OF SEDGWICK, COUNTY OF KANSAS, ss.
Vicky Jacobs (employee of owner) or (~~owner~~) of the above-described
well, being first duly sworn on oath, says: That I have knowledge of the facts, statements, and matters herein contained and the log of the
above-described well as filed and that the same are true and correct. So help me God.

(Signature) Vicky Jacobs Office Manager
107 Rule Building, Wichita, Kansas
(Address)

SUBSCRIBED AND SWORN TO before me this 17th day of March, 1954

Barbara Donaldson
Notary Public.

My commission expires June 17, 1957

24-7368-B 3-53-20M

PLUGGING
FILE SEC 7 T 10 R 19W
BOOK PAGE 19 LINE 23

RECEIVED
STATE CORPORATION COMMISSION
3-18-54
MAR 18 1954
CONSERVATION DIVISION
Wichita, Kansas

CONTRACTOR'S WELL LOG

OPERATOR C-G Drilling Co. FARM NAME Dunlap #5
 LOCATION SW NW SW, Sec. 7-10S-19W
 POOL NAME Marcotte COUNTY Rooks STATE Kansas
 COMMENCEMENT DATE 7-15-51 COMPLETION DATE 7-24-51

LOG OF WELL

Elevation: 2237' R.B.
 All measurements from the top of Rotary Bushing.

FROM	TO	FORMATION	DEVIATION FROM VERTICAL	REMARKS:
0	110	Shale-Sand		
110	190	Shale-Sand		
190	825	Shale-Sand		
825	890	Sand		
890	1130	Shale-Shells		
1130	1145	Sand		
1145	1330	Sand		
1330	1647	Shale	0° - 1500'	
1647	1660	Anhydrite		
1660	1685	Anhydrite		
1685	2000	Shale	0° - 2000'	
2000	2200	Lime-Shale		
2200	2350	Lime-Shale		
2350	2470	Lime-Shale		
2470	2570	Lime-Shale	0° - 2500'	
2570	2660	Lime-Shale		
2660	2745	Lime-Shale		
2745	2870	Lime-Shale		
2870	2940	Lime-Shale		
2940	3040	Lime-Shale	0° - 3000'	
3040	3115	Lime-Shale		
3115	3225	Lime-Shale		
3225	3340	Lime-Shale		
3340	3385	Lime		
3385	3440	Lime-Shale		
3440	3496	Lime		
3496	3565	Lime	0° - 3500'	
3565	3610	Lime		
3610	3650	Lime		
3650	3725	Lime-Shale		
3725	3765	Conglomerate		
3765	3785	Lime-Shale		


CASING LEFT IN HOLE AFTER COMPLETION

Ran 190.39' of 8-5/8" Surface Casing.
 Ran 3795.03' (139 jts) 4-1/2" OD Casing.

STATE OF KANSAS, COUNTY OF SEDGWICK) ss.

The undersigned certifies that to the best of her knowledge and belief, the above facts are true and correct.

C-G DRILLING CO.

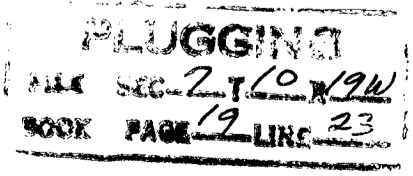

By Vicky Jacobs Office Manager

Subscribed and sworn to before me this 17th day of March, 1954.

My commission expires: June 17, 1957

Barbara Donaldson
 Notary Public