


WELL PLUGGING RECORD

Give All Information Completely
Make Required Affidavit
Mail or Deliver Report to:
Conservation Division
State Corporation Commission
212 North Market, Insurance Bldg.
Wichita, Kansas

ROOKS County. Sec. 7 Twp. 10 Rge. 19 (X) W (W)
Location as "NE/CNW%SW%" or footage from lines NE SW SE SW

Lease Owner C-G Drilling Company
Lease Name ATHERTON Well No. 4
Office Address 107 Rule Bldg. Wichita, Kansas

Character of Well (completed as Oil, Gas or Dry Hole) oil
Date well completed April 21 19 61
Application for plugging filed April 21 19 61
Application for plugging approved April 21 19 61
Plugging commenced April 21, 19 61
Plugging completed April 23 19 61
Reason for abandonment of well or producing formation oil resevoir depleted

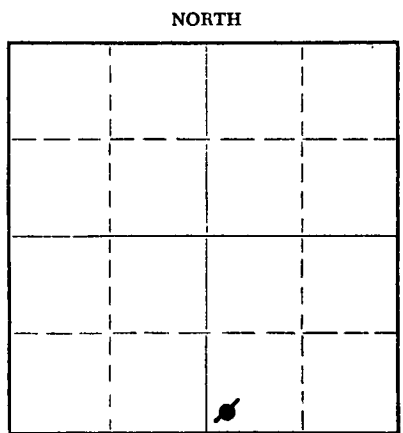

Locate well correctly on above
Section Plat

If a producing well is abandoned, date of last production September 30, 1955
Was permission obtained from the Conservation Division or its agents before plugging was commenced? yes

Name of Conservation Agent who supervised plugging of this well Eldon Petty, Hays, Kansas
Producing formation _____ Depth to top _____ Bottom _____ Total Depth of Well 3783 Feet
Show depth and thickness of all water, oil and gas formations.

OIL, GAS OR WATER RECORDS

CASING RECORD

FORMATION	CONTENT	FROM	TO	SIZE	PUT IN ^{FT}	PULLED OUT
				8 5/8	230264	none
				5 1/2	3782	1025.49

Describe in detail the manner in which the well was plugged, indicating where the mud fluid was placed and the method or methods used in introducing it into the hole. If cement or other plugs were used, state the character of same and depth placed, from _____ feet to _____ feet for each plug set.

Plugged back to 3716' with 16' of sand and 5 sacks of cement.
Circulated 20 sacks of gel.
Spotted 20 sacks of cement.
Spotted 20 sacks of cement.
Capped with 10 sacks of cement.

5-11-61
CONSERVATION DIVISION
Wichita, Kansas

(If additional description is necessary, use BACK of this sheet)

Name of Plugging Contractor PIPE PULLERS, INC.
Address ELLINWOOD, KANSAS

STATE OF KANSAS, COUNTY OF SEDGWICK, ss.
G. F. Galloway (employee of owner) or (owner or operator) of the above-described well, being first duly sworn on oath, says: That I have knowledge of the facts, statements, and matters herein contained and the log of the above-described well as filed and that the same are true and correct. So help me God.

(Signature) G. F. Galloway
107 Rule Building
(Address)

SUBSCRIBED AND SWORN TO before me this 5th day of May, 1961

My commission expires May 20, 1963

Vicky Jacobs
Vicky Jacobs - Notary Public.



W E L L L O G

OPERATOR C-G Drilling Co. SEC. 7-10-19W
 WELL NAME Atherton #4 ^{2 1/2} NE
 LOC. SW SE SW
 TOTAL DEPTH 3790' COUNTY Rooks
 COMM. August 9, 1949 ^{Drilling} COMP. September 22, 1949 STATE Kansas
 RIG NO. 1 ELEVATION 2233' D.F.
 CASING: Left in hole 264.40' (9 jts.) 8-5/8" PRODUCTION: Abandoned
 OD Surface Casing.
 And 5-1/2" OD Casing 2756.51'

All measurements taken from the top of rotary bushing.

FROM	TO	FORMATION	DEVIATION FROM VERTICAL	REMARKS:
0	260	Sand & Shale		
260	979	Shale & Sand		
979	1127	Shale & Shells		
1127	1300	Sand		
1300	1365	Shale & Sand		
1365	1654	Shale & Shells		
1654	1687	Anhydrite		
1687	2110	Shale & Shells		
2110	2500	Shale & Lime	0° - 2500	
2500	2580	Lime		
2580	2655	Lime & Shale	0° - 2750	
2655	2730	Lime	0° - 3000	
2730	3370	Shale & Lime	0° - 3250	
3370	3790	Lime	0° - 3500	
			0° - 3750	

RECEIVED
 STATE CORPORATION COMMISSION
 MAY 11 1961
 CONSERVATION DIVISION
 Wichita, Kansas

STATE OF KANSAS }
 COUNTY OF SEDGWICK } SS.

The undersigned hereby certifies that to the best of his knowledge and belief, the above facts are true and correct.

C-G DRILLING CO.
 By G. F. Galloway
 G. F. Galloway

SUBSCRIBED AND SWORN TO, BEFORE ME, THIS 9th day of May, 1961.
Vicky Jacobs
 Vicky Jacobs - Notary public

