


STATE OF KANSAS
STATE CORPORATION COMMISSION

WELL PLUGGING RECORD

Give All Information Completely
Make Required Affidavit
Mail or Deliver Report to
Conservation Division
State Corporation Comm.
245 North Water
Wichita, KS 67202

Rocks _____ County. Sec. 9 Twp. 10 Rge. 19 E/W
Location as "NE/CNW $\frac{1}{2}$ SW $\frac{1}{4}$ " or footage from lines _____
NW NW NW
Lease Owner John P. Jennings
Lease Name Baldwin Well No. 4
Office Address Box 1340, Lawrence, Kansas 66044
Character of Well (Completed as Oil, Gas or Dry Hole) _____
Salt Water Disposal
Date Well completed May 4 1987
Application for plugging filed July 12 1983
Application for plugging approved _____ 1983
Plugging commenced August 10 1983
Plugging completed August 16 1983
Reason for abandonment of well or producing formation _____
Stopped Taking Water
If a producing well is abandoned, date of last production _____ 1983
Was permission obtained from the Conservation Division or its agents before plugging was commenced? Yes

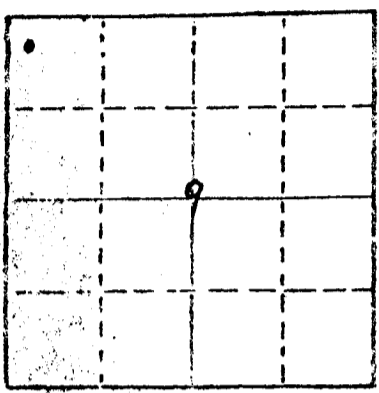

Locate well correctly on above Section Plot

Name of Conservation Agent who supervised plugging of this well Dennis Hamel
Disposal formation Arbuckle Depth to top 3765 Bottom 3794+ Total Depth of Well 3794
Show depth and thickness of all water, oil and gas formations.

OIL, GAS OR WATER RECORDS

CASING RECORD

| FORMATION | CONTENT | FROM | TO | SIZE | PUT IN | PULLED OUT |
|-----------|---------|------|----|------|--------|------------|
| | | | | | | |
| | | | | | | |
| | | | | | | |
| | | | | | | |

Describe in detail the manner in which the well was plugged, indicating where the mud fluid was placed and the method or methods used in introducing it into the hole. If cement or other plugs were used, state the character of same and depth placed, from _____ feet to _____ feet for each plug set. Mixed 25 sacks of 50/50 poz mix with 6% gel and 1 sack of hulls mixed in. Pumped down casing and followed with 16 sacks of gel. Mixed 75 sacks of 50/50 poz with 6% gel and 1 sack of hulls and pumped down casing. Mixed 150 sacks of 50/50 poz with 6% gel and 2 sacks of hulls and pumped down annulas between casing and surface pipe. Maximum pressure was 300 lbs. on annulas and didn't have any pressure on casing.

(If additional description is necessary, use BACK of this sheet)

Name of Plugging Contractor Pfeifer-Sharpe, Inc.

STATE OF Kansas COUNTY OF Graham, ss.
Bill Daily (employee of owner) or (owner or operator)
of the above-described well, being first duly sworn on oath, says: That I have knowledge of the facts, statements, and matters herein contained and the log of the above-described well as filed and that the same are true and correct. So help me God.

(Signature) William A. Daily
P. O. Box 386, Hill City, Kansas 67642
(Address)

SUBSCRIBED AND SWORN TO before me this 29th day of August, 1983

Debra L. Pfeifer-Wente
Notary Public.

My commission expires May **RECEIVED**
STATE CORPORATION COMMISSION

8-31-83
AUG 31 1983

CONSERVATION DIVISION
Wichita, Kansas

Debra L. Pfeifer-Wente
NOTARY PUBLIC
State of Kansas
My Appointment Expires: