

15-163-03373-0000


STATE OF KANSAS
STATE CORPORATION COMMISSION

WELL PLUGGING RECORD

Give All Information Completely
Make Required Affidavit
Mail or Deliver Report to:
Conservation Division
State Corporation Commission
211 No. Broadway
Wichita, Kansas

Rooks County. Sec. 7 Twp. 10 Rge. (E) 19(W)
Location as "NE/CNW/SW" or footage from lines NW SW SW
Lease Owner C-G Drilling Co.
Lease Name Dunlap Well No. 4
Office Address 107 Rule Building, Wichita, Kansas
Character of Well (completed as Oil, Gas or Dry Hole) Oil well
Date well completed November 30 19 50
Application for plugging filed March 15 19 57
Application for plugging approved March 15 19 57
Plugging commenced March 18 19 57
Plugging completed March 18 19 57
Reason for abandonment of well or producing formation No longer commercial

NORTH

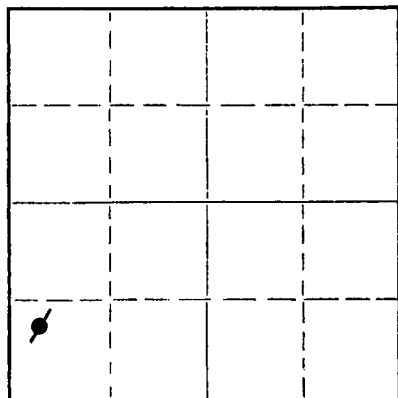

Locate well correctly on above
Section Plat

If a producing well is abandoned, date of last production March 19 56
Was permission obtained from the Conservation Division or its agents before plugging was commenced? Yes

Name of Conservation Agent who supervised plugging of this well Eldon Petty, Hays, Kansas
Producing formation Arbuckle Depth to top 3775 Bottom 3781 Total Depth of Well 3781 Feet
Show depth and thickness of all water, oil and gas formations.

OIL, GAS OR WATER RECORDS

CASING RECORD

FORMATION	CONTENT	FROM	TO	SIZE	PUT IN	PULLED OUT
				8-5/8"	251'	none
				5-1/2"	3786'	none
					P1 KCC	

Describe in detail the manner in which the well was plugged, indicating where the mud fluid was placed and the method or methods used in introducing it into the hole. If cement or other plugs were used, state the character of same and depth placed, from _____ feet to _____ feet for each plug set.

Ran in 40 sacks Davis Gel. Could not put in cement because of pressure of 1300 lbs. Would not take cement.

(If additional description is necessary, use BACK of this sheet)

Name of Plugging Contractor C-G Drilling Co.
Address 107 Rule Building, Wichita, Kansas

STATE OF KANSAS, COUNTY OF SEDGWICK, ss.
Jay H. Galloway (employee of owner) or (owner or operator) of the above-described well, being first duly sworn on oath, says: That I have knowledge of the facts, statements, and matters herein contained and the log of the above-described well as filed and that the same are true and correct. So help me God.

(Signature) Jay H. Galloway
Jay H. Galloway 107 Rule Bldg.
(Address)

SUBSCRIBED AND SWORN TO before me this 8th day of April, 19 57

My commission expires May 20, 1959

Vicky Jacobs
Vicky Jacobs Notary Public.

PLUGGING
FILE SEC. 7 T. 10 R. 19w
BOOK PAGE 2 LINE 45

APR 10 1957
CONSERVATION DIVISION

CONTRACTOR'S WELL LOG

OPERATOR C-G Drilling WELL NAME Dunlap #4
 LOCATION NW SW SW 7-10-19 RIG NO. 1
 COUNTY Rooks STATE Kansas
 COMMENCEMENT DATE November 18, 1950 COMPLETION DATE November 27, 1950
 PLUGGING COMMENCED March 15, 1957 PLUGGING COMPLETED March 18, 1957

LOG OF WELL

Elevation 2230' rotary bushing.
 All measurements taken from the top of rotary bushing.

FROM	TO	FORMATION	DEVIATION FROM VERTICAL	REMARKS:
0	250	Surface Soil		
250	340	Shale		
340	709	Shale-Sand		
709	1065	Shale-Sand-Shells		
1065	1125	Shale-Shells		
1125	1340	Sand		
1340	1583	Shale-Shells		
1583	1636	Shale-Shells		
1636	1670	Anhydrite		
1670	1900	Shale-Shells		
1900	2180	Shale-Shells		
2180	2305	Lime-Shale		
2305	2500	Lime-Shale	0° - 2500	
2500	2655	Lime-Shale		
2655	2765	Lime-Shale	0° - 2750	
2765	2985	Lime-Shale		
2985	3150	Lime-Shale	0° - 3000	
3150	3280	Lime-Shale	0° - 3250	
3280	3425	Lime-Shale		
3425	3500	Lime	0° - 3500	
3500	3605	Lime		
3605	3781	Lime	0° - 3750	

CASING LEFT IN HOLE AFTER COMPLETION

Set 251' (12 jts.) 8-5/8" OD Surface Casing.
 Set 3776-1/2' (123 jts.) 5-1/2" OD Casing

STATE OF KANSAS }
 COUNTY OF SEDGWICK } ss.

The undersigned hereby certifies that to the best of his knowledge and belief, the above facts are true and correct.

C-G DRILLING CO

By Jay H. Galloway
 Jay H. Galloway

Subscribed and sworn to before me this 8th day of April, 1957.

Vicky Jacobs
 Vicky Jacobs, Notary Public

My commission expires:
 May 20, 1959

PLUGGING
 SEC 7 T 10 R 19W
 BOOK PAGE 2 LINE 45