


Give All Information Completely
Make Required Affidavit
Mail or Deliver Report to:
Conservation Division
State Corporation Commission
211 No. Broadway
Wichita, Kansas

WELL PLUGGING RECORD

NORTH

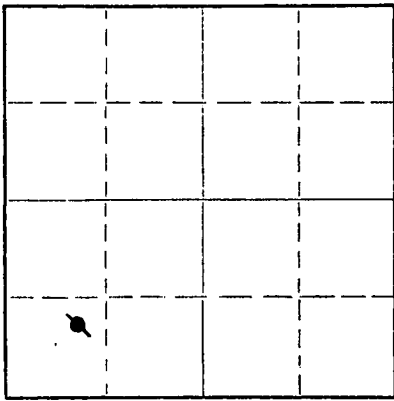

Locate well correctly on above
Section Plat

Rooks County, Sec. 7 Twp. 10S Rge. 19 (E) W (W)
Location as "NE/CNW/SW" or footage from lines SE SW SW
Lease Owner C-G Drilling Co.
Lease Name Dunlap Well No. I
Office Address 107 Rule Building
Character of Well (completed as Oil, Gas or Dry Hole) oil well
Date well completed April 21 1949
Application for plugging filed March 15 1957
Application for plugging approved March 15 1957
Plugging commenced March 18 1957
Plugging completed April 19 1957
Reason for abandonment of well or producing formation No longer commercial

If a producing well is abandoned, date of last production April 1954
Was permission obtained from the Conservation Division or its agents before plugging was commenced? Yes

Name of Conservation Agent who supervised plugging of this well Eldon Petty
Producing formation Arbuckle Depth to top 3778 Bottom 3788 Total Depth of Well 3788 Feet
Show depth and thickness of all water, oil and gas formations.

OIL, GAS OR WATER RECORDS

CASING RECORD

FORMATION	CONTENT	FROM	TO	SIZE	PUT IN	PULLED OUT
		Top	251'	8-5/8"	251.	none
		Top	3780'	5-1/2"	3780'	none

Describe in detail the manner in which the well was plugged, indicating where the mud fluid was placed and the method or methods used in introducing it into the hole. If cement or other plugs were used, state the character of same and depth placed, from _____ feet to _____ feet for each plug set.

Pumped in 40 sacks Gel; set plug. Put in 40 sacks cement, filled with mud to 35' from top of hole. Used 5 sacks cement to complete plugging of hole.

4-27-57

(If additional description is necessary, use BACK of this sheet)

Name of Plugging Contractor C-G DRILLING CO.
Address 107 Rule Building, Wichita, Kansas

STATE OF Kansas, COUNTY OF Sedgwick, ss.


Jay H. Galloway (employee of owner) or (owner or operator) of the above-described well, being first duly sworn on oath, says: That I have knowledge of the facts, statements, and matters herein contained and the log of the above-described well as filed and that the same are true and correct. So help me God.

(Signature) Jay H. Galloway
107 Rule Bldg., Wichita, Kansas
(Address)

SUBSCRIBED AND SWORN TO before me this 22nd day of April, 1957

Vicky Jacobs
Notary Public.

My commission expires May 20, 1959

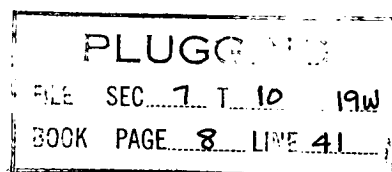

CONTRACTOR'S WELL LOG

OPERATOR C-G DRILLING CO. WELL NAME Dunlap #1

LOCATION SE/4 SW/4 SW/4 Sec. 7, T. 10S., R. 19W.

COUNTY ROOKS STATE KANSAS

COMMENCEMENT DATE April 7, 1949 COMPLETION DATE April 21, 1949

PLUGGING COMMENCED March 18, 1957 PLUGGING COMPLETED April 19, 1957

LOG OF WELL

Elevation 2234' Rotary Bushing.
All measurements taken from the top of rotary bushing.

FROM	TO	FORMATION	DEVIATION FROM VERTICAL	REMARKS:
0	250	Surface soil		
250	900	Shale		
900	1125	Shale		
1125	1375	Sand-Shale		
1375	1638	Shale-Shells		
1638	1685	Anhydrite		
1685	1880	Shale-Shells		
1880	1980	Shale-Shells		
1980	2215	Shale-Lime		
2215	2390	Lime-Shale		
2390	2495	Shale-Lime		
2495	2560	Lime	0° - 2500'	
2560	2745	Lime-Shale		
2745	2925	Lime-Shale		
2925	3220	Lime	0° - 3000'	
3220	3395	Lime	0° - 3250'	
3395	3516	Lime	0° - 3500'	
3516	3786	Lime	0° - 3750'	
3786	3788			

CASING LEFT IN HOLE AFTER WELL PLUGGED

Set 251,28' (12 jts.) of 8-5/8" OD Surface Casing.

Set 3780' (118 jts.) of 5-1/2" OD Production Casing.

STATE OF KANSAS }
COUNTY OF SEDGWICK } ss.

The undersigned hereby certifies that to the best of his knowledge and belief, the above facts are true and correct.

C-G DRILLING CO
By Jay H. Galloway
Jay H. Galloway

Subscribed and sworn to before me this 22nd day of April, 1957.

My commission expires: Vicky Jacobs
Vicky Jacobs, Notary Public

May 20, 1959

PLUGGING
SEC. 7 T. 10 R. 19W
BOOK PAGE 8 LINE 41